


EV

811 Main, Sylvia, Kansas

Application Number:

submitted Water Well Disinfected? Yes No ☒

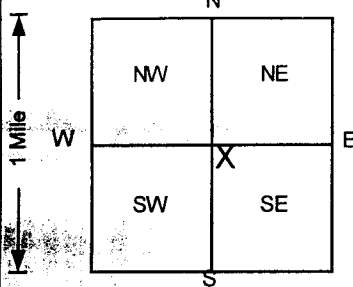

From ft. to ft. From ft. to ft.

Other (specify below)
AST

FROM	TO	LITHOLOGIC LOG	FROM	TO	PLUGGING INTERVALS
0	1	Sand and Gravel (fill),			
1	2	Sand, Brown			
2	7	Sand, Red Brown			
7	11	Sand, Brown			
11	16	Sand, Light Brown to Tan			
16	20	Sand, Brown			
20	25	Sand, Brown			
					MW6R , Tag # 00355885 , Flushmount
					Project Name: Greenfield - Sylvia Coop
					GeoCore # 897 , KDHE # A2 078 40106

7 CONTRACTOR'S OR LANDOWNER'S CERTIFICATION: This water well was (1) constructed, (2) reconstructed, or (3) plugged under my jurisdiction and was completed on (mo/day/year) 9/10/02 and this record is true to the best of my knowledge and belief.
Kansas Water Well Contractor's License No. 527 This Water Well Record was completed on (mo/day/yr) 10/30/02 under the business name of GeoCore Inc. by (signature) [Signature]