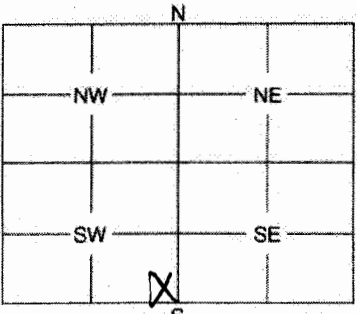


1	LOCATION OF WATER WELL: Reno	Fraction SE $\frac{1}{4}$ SE $\frac{1}{4}$ SW $\frac{1}{4}$	Section Number 15	Township Number 24	Range Number 10
County: Reno					

Distance and direction from nearest town or city street address of well if located within city?

Old Hwy 50 & Main, Sylvania, Kansas

2	WATER WELL OWNER: Martin Motors c/o Dave Hederstedt	
RR #, St. Address, Box #: P.O. Box 913		Board of Agriculture, Division of Water Resources
City, State, ZIP Code: Hutchinson, Ks 67504-0913		Application Number:

3	MARK WELL'S LOCATION WITH AN "X" IN SECTION BOX: 	4	DEPTH OF WELL 15 ft. WELL'S STATIC WATER LEVEL 11.69 ft. WELL WAS USED AS: <table><tr><td>1 Domestic</td><td>5 Public Water Supply</td><td>9 Dewatering</td></tr><tr><td>2 Irrigation</td><td>6 Oil Field Water Supply</td><td>10 Monitoring Well</td></tr><tr><td>3 Feedlot</td><td>7 Domestic (Lawn & Garden)</td><td>11 Injection Well</td></tr><tr><td>4 Industrial</td><td>8 Air Conditioning</td><td>12 Other</td></tr></table>	1 Domestic	5 Public Water Supply	9 Dewatering	2 Irrigation	6 Oil Field Water Supply	10 Monitoring Well	3 Feedlot	7 Domestic (Lawn & Garden)	11 Injection Well	4 Industrial	8 Air Conditioning	12 Other
1 Domestic	5 Public Water Supply	9 Dewatering													
2 Irrigation	6 Oil Field Water Supply	10 Monitoring Well													
3 Feedlot	7 Domestic (Lawn & Garden)	11 Injection Well													
4 Industrial	8 Air Conditioning	12 Other													
Was a chemical / bacteriological sample submitted to Department? Yes No X If yes, mo/day/yr sample was submitted															
Water Well Disinfected: Yes No X															

5	TYPE OF BLANK CASING USED: <table><tr><td>1 Steel</td><td>3 RMP (SR)</td><td>5 Wrought</td><td>7 Fiberglass</td><td>9 Other (Specify below)</td></tr><tr><td>2 PVC</td><td>4 ABS</td><td>6 Asbestos-Cement</td><td>8 Concrete Tile</td><td></td></tr></table>		1 Steel	3 RMP (SR)	5 Wrought	7 Fiberglass	9 Other (Specify below)	2 PVC	4 ABS	6 Asbestos-Cement	8 Concrete Tile	
1 Steel	3 RMP (SR)	5 Wrought	7 Fiberglass	9 Other (Specify below)								
2 PVC	4 ABS	6 Asbestos-Cement	8 Concrete Tile									
Blank casing diameter 2 in.		Was casing pulled? Yes X No	If yes, how much 15'									
Casing height above or below land surface		in.										

6	GROUT PLUG MATERIAL: 3 1 Neat cement 2 Cement grout 3 Bentonite 4 Other surface silts/clays															
Grout Plug Intervals: From 15 ft. to 2 ft., From 2 ft. to 0 ft., From to ft.																
What is the nearest source of possible contamination: <table><tr><td>1 Septic tank</td><td>6 Seepage pit</td><td>11 Fuel storage</td></tr><tr><td>2 Sewer lines</td><td>7 Pit privy</td><td>12 Fertilizer storage</td></tr><tr><td>3 Watertight sewer lines</td><td>8 Sewage lagoon</td><td>13 Insecticide storage</td></tr><tr><td>4 Lateral lines</td><td>9 Feedyard</td><td>14 Abandoned water well</td></tr><tr><td>5 Cess pool</td><td>10 Livestock pens</td><td>15 Oil well/Gas well</td></tr></table>		1 Septic tank	6 Seepage pit	11 Fuel storage	2 Sewer lines	7 Pit privy	12 Fertilizer storage	3 Watertight sewer lines	8 Sewage lagoon	13 Insecticide storage	4 Lateral lines	9 Feedyard	14 Abandoned water well	5 Cess pool	10 Livestock pens	15 Oil well/Gas well
1 Septic tank	6 Seepage pit	11 Fuel storage														
2 Sewer lines	7 Pit privy	12 Fertilizer storage														
3 Watertight sewer lines	8 Sewage lagoon	13 Insecticide storage														
4 Lateral lines	9 Feedyard	14 Abandoned water well														
5 Cess pool	10 Livestock pens	15 Oil well/Gas well														
Direction from well?		How many feet?														

FROM	TO	PLUGGING MATERIALS
15	2	Bentonite grout
2	0	surface silts/clays

7	CONTRACTOR'S OF LANDOWNER'S CERTIFICATION: This water well was plugged under my jurisdiction and was completed on (mo/day/year) 10/10/06 and this record is true to the best of my knowledge and belief. Kansas Water Well Contractor's License No. 585 This Water Well Record was completed on (mo/day/year) 11/01/06 under the business name of Associated Environmental, Inc. by (signature) B. Johnson	
---	--	--

INSTRUCTIONS: Use typewriter or ball point pen. Please press firmly and print clearly. Please fill in blanks, underline or circle the correct answers. Send top three copies to Kansas Department of Health and Environment, Bureau of Water, Geology Section, 1000 SW Jackson St., Ste. 420, Topeka, Kansas 66612-1367. Telephone: 785/296-5522. Send one to Water Well Owner and retain one for your records.