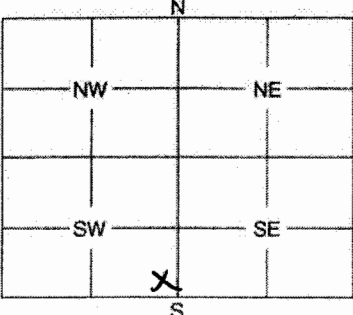


1	LOCATION OF WATER WELL: Reno	Fraction SE $\frac{1}{4}$ SE $\frac{1}{4}$ SW $\frac{1}{4}$	Section Number 15	Township Number 24	Range Number 10
---	--	--	-----------------------------	------------------------------	---------------------------

County:

Distance and direction from nearest town or city street address of well if located within city?
Old Hwy 50 & Main, Sylvania, Kansas

2	WATER WELL OWNER: Martin Motors c/o Dave Hederstedt
	RR #: St. Address, Box #: P.O. Box 913
	City, State, ZIP Code: Hutchinson, Ks 67504-0913
	Board of Agriculture, Division of Water Resources Application Number:

3	MARK WELL'S LOCATION WITH AN "X" IN SECTION BOX: 	4	DEPTH OF WELL 19 ft. WELL'S STATIC WATER LEVEL 15.5 ft. WELL WAS USED AS: 1 Domestic 2 Irrigation 3 Feedlot 4 Industrial 5 Public Water Supply 6 Oil Field Water Supply 7 Domestic (Lawn & Garden) 8 Air Conditioning 9 Dewatering 10 <u>Monitoring Well</u> 11 Injection Well 12 Other
---	--	---	---

Was a chemical / bacteriological sample submitted to Department? Yes No X
If yes, mo/day/yr sample was submittedWater Well Disinfected: Yes No X

5	TYPE OF BLANK CASING USED: 1 Steel 2 <u>PVC</u> 3 RMP (SR) 4 ABS 5 Wrought 6 Asbestos-Cement 7 Fiberglass 8 Concrete Tile 9 Other (Specify below)
---	--

Blank casing diameter **2** in. Was casing pulled? Yes X No If yes, how much **19'**
Casing height above or below land surface in.

6	GROUT PLUG MATERIAL: 3 1 Neat cement 2 Cement grout 3 Bentonite 0 Other surface silts/clays Grout Plug Intervals: From 19 ft. to 2 ft., From 2 ft. to 0 ft., From to ft.
---	---

What is the nearest source of possible contamination:

- | | | | |
|--------------------------|-------------------|-------------------------|--------------------------------|
| 1 Septic tank | 6 Seepage pit | 11 Fuel storage | 16 Other (specify below) |
| 2 Sewer lines | 7 Pit privy | 12 Fertilizer storage | |
| 3 Watertight sewer lines | 8 Sewage lagoon | 13 Insecticide storage | |
| 4 Lateral lines | 9 Feedyard | 14 Abandoned water well | |
| 5 Cess pool | 10 Livestock pens | 15 Oil well/Gas well | |

Direction from well? How many feet?

FROM	TO	PLUGGING MATERIALS
19	2	Bentonite grout
2	0	surface silts/clays

7	CONTRACTOR'S OF LANDOWNER'S CERTIFICATION: This water well was plugged under my jurisdiction and was completed on (mo/day/year) 10/10/06 and this record is true to the best of my knowledge and belief. Kansas Water Well Contractor's License No. 585 This Water Well Record was completed on (mo/day/year) 11/01/06 under the business name of Associated Environmental, Inc. by (signature) B. Johnson
---	--

INSTRUCTIONS: Use typewriter or ball point pen. Please press firmly and print clearly. Please fill in blanks, underline or circle the correct answers. Send top three copies to Kansas Department of Health and Environment, Bureau of Water, Geology Section, 1000 SW Jackson St., Ste. 420, Topeka, Kansas 66612-1367. Telephone: 785/296-5522. Send one to Water Well Owner and retain one for your records.