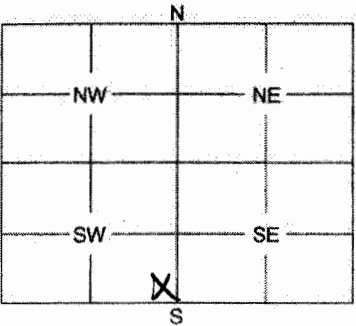


| 1 LOCATION OF WATER WELL: County: Reno | Fraction SE $\frac{1}{4}$ SE $\frac{1}{4}$ SW $\frac{1}{4}$ | Section Number 15 | Township Number 24 | Range Number 10 | EW | | | | | | | | | | | | | | | | | | | | | | | | | | | |
|---|---|---|-------------------------------------|----------------------------------|-----------|---------------|-----------------------|--------------------|--------------------------|--------------------------|--------------------|-----------------------|----------------------------|--------------------------|-----------------|------------------------|----------------|-----------------|------------|-------------------------|--|-------------|-------------------|----------------------|--|--|--|--|--|--|--|--|
| Distance and direction from nearest town or city street address of well if located within city? Old Hwy 50 & Main, Sylvania, Kansas | | | | | | | | | | | | | | | | | | | | | | | | | | | | | | | | |
| 2 WATER WELL OWNER: Martin Motors c/o Dave Hederstedt RR #, St. Address, Box #: P.O. Box 913 City, State, ZIP Code: Hutchinson, Ks 67504-0913 Board of Agriculture, Division of Water Resources Application Number: | | | | | | | | | | | | | | | | | | | | | | | | | | | | | | | | |
| 3 MARK WELL'S LOCATION WITH AN "X" IN SECTION BOX: <div style="text-align: center;"></div> | | 4 DEPTH OF WELL 17 ft. WELL'S STATIC WATER LEVEL 12.97 ft. WELL WAS USED AS: <table style="width:100%;"><tr><td>1 Domestic</td><td>5 Public Water Supply</td><td>9 Dewatering</td></tr><tr><td>2 Irrigation</td><td>6 Oil Field Water Supply</td><td>10 Monitoring Well</td></tr><tr><td>3 Feedlot</td><td>7 Domestic (Lawn & Garden)</td><td>11 Injection Well</td></tr><tr><td>4 Industrial</td><td>8 Air Conditioning</td><td>12 Other</td></tr></table> Was a chemical / bacteriological sample submitted to Department? Yes No <u>X</u> If yes, mo/day/yr sample was submitted Water Well Disinfected: Yes No <u>X</u> | | | | 1 Domestic | 5 Public Water Supply | 9 Dewatering | 2 Irrigation | 6 Oil Field Water Supply | 10 Monitoring Well | 3 Feedlot | 7 Domestic (Lawn & Garden) | 11 Injection Well | 4 Industrial | 8 Air Conditioning | 12 Other | | | | | | | | | | | | | | | |
| 1 Domestic | 5 Public Water Supply | 9 Dewatering | | | | | | | | | | | | | | | | | | | | | | | | | | | | | | |
| 2 Irrigation | 6 Oil Field Water Supply | 10 Monitoring Well | | | | | | | | | | | | | | | | | | | | | | | | | | | | | | |
| 3 Feedlot | 7 Domestic (Lawn & Garden) | 11 Injection Well | | | | | | | | | | | | | | | | | | | | | | | | | | | | | | |
| 4 Industrial | 8 Air Conditioning | 12 Other | | | | | | | | | | | | | | | | | | | | | | | | | | | | | | |
| 5 TYPE OF BLANK CASING USED: <table style="width:100%;"><tr><td>1 Steel</td><td>3 RMP (SR)</td><td>5 Wrought</td><td>7 Fiberglass</td><td>9 Other (Specify below)</td></tr><tr><td>2 PVC</td><td>4 ABS</td><td>6 Asbestos-Cement</td><td>8 Concrete Tile</td><td></td></tr></table> Blank casing diameter in. Was casing pulled? Yes <u>X</u> No If yes, how much 17 Casing height above or below land surface in. | | | | | | 1 Steel | 3 RMP (SR) | 5 Wrought | 7 Fiberglass | 9 Other (Specify below) | 2 PVC | 4 ABS | 6 Asbestos-Cement | 8 Concrete Tile | | | | | | | | | | | | | | | | | | |
| 1 Steel | 3 RMP (SR) | 5 Wrought | 7 Fiberglass | 9 Other (Specify below) | | | | | | | | | | | | | | | | | | | | | | | | | | | | |
| 2 PVC | 4 ABS | 6 Asbestos-Cement | 8 Concrete Tile | | | | | | | | | | | | | | | | | | | | | | | | | | | | | |
| 6 GROUT PLUG MATERIAL: 1 Neat cement 2 Cement grout 3 Bentonite 4 Other <u>surface silts/clays</u> GROUT PLUG INTERVALS: From 17 ft. to 2 ft., From 2 ft. to 0 ft., From to ft. What is the nearest source of possible contamination: <table style="width:100%;"><tr><td>1 Septic tank</td><td>6 Seepage pit</td><td>11 Fuel storage</td><td>16 Other (specify below)</td></tr><tr><td>2 Sewer lines</td><td>7 Pit privy</td><td>12 Fertilizer storage</td><td></td></tr><tr><td>3 Watertight sewer lines</td><td>8 Sewage lagoon</td><td>13 Insecticide storage</td><td></td></tr><tr><td>4 Lateral lines</td><td>9 Feedyard</td><td>14 Abandoned water well</td><td></td></tr><tr><td>5 Cess pool</td><td>10 Livestock pens</td><td>15 Oil well/Gas well</td><td></td></tr></table> Direction from well? How many feet? | | | | | | 1 Septic tank | 6 Seepage pit | 11 Fuel storage | 16 Other (specify below) | 2 Sewer lines | 7 Pit privy | 12 Fertilizer storage | | 3 Watertight sewer lines | 8 Sewage lagoon | 13 Insecticide storage | | 4 Lateral lines | 9 Feedyard | 14 Abandoned water well | | 5 Cess pool | 10 Livestock pens | 15 Oil well/Gas well | | | | | | | | |
| 1 Septic tank | 6 Seepage pit | 11 Fuel storage | 16 Other (specify below) | | | | | | | | | | | | | | | | | | | | | | | | | | | | | |
| 2 Sewer lines | 7 Pit privy | 12 Fertilizer storage | | | | | | | | | | | | | | | | | | | | | | | | | | | | | | |
| 3 Watertight sewer lines | 8 Sewage lagoon | 13 Insecticide storage | | | | | | | | | | | | | | | | | | | | | | | | | | | | | | |
| 4 Lateral lines | 9 Feedyard | 14 Abandoned water well | | | | | | | | | | | | | | | | | | | | | | | | | | | | | | |
| 5 Cess pool | 10 Livestock pens | 15 Oil well/Gas well | | | | | | | | | | | | | | | | | | | | | | | | | | | | | | |
| <table border="1" style="width:100%; border-collapse: collapse;"><thead><tr><th style="width:15%;">FROM</th><th style="width:15%;">TO</th><th style="width:70%;">PLUGGING MATERIALS</th></tr></thead><tbody><tr><td>17</td><td>2</td><td>Bentonite grout</td></tr><tr><td>2</td><td>0</td><td>surface silts/clays</td></tr><tr><td> </td><td> </td><td> </td></tr><tr><td> </td><td> </td><td> </td></tr><tr><td> </td><td> </td><td> </td></tr><tr><td> </td><td> </td><td> </td></tr><tr><td> </td><td> </td><td> </td></tr><tr><td> </td><td> </td><td> </td></tr></tbody></table> | | | | | | FROM | TO | PLUGGING MATERIALS | 17 | 2 | Bentonite grout | 2 | 0 | surface silts/clays | | | | | | | | | | | | | | | | | | |
| FROM | TO | PLUGGING MATERIALS | | | | | | | | | | | | | | | | | | | | | | | | | | | | | | |
| 17 | 2 | Bentonite grout | | | | | | | | | | | | | | | | | | | | | | | | | | | | | | |
| 2 | 0 | surface silts/clays | | | | | | | | | | | | | | | | | | | | | | | | | | | | | | |
| | | | | | | | | | | | | | | | | | | | | | | | | | | | | | | | | |
| | | | | | | | | | | | | | | | | | | | | | | | | | | | | | | | | |
| 7 CONTRACTOR'S OF LANDOWNER'S CERTIFICATION: This water well was plugged under my jurisdiction and was completed on (mo/day/year) <u>10/10/06</u> and this record is true to the best of my knowledge and belief. Kansas Water Well Contractor's License No. <u>585</u> This Water Well Record was completed on (mo/day/year) <u>11/01/06</u> under the business name of <u>Associated Environmental, Inc.</u> by (signature) <u>B. Johnson</u> | | | | | | | | | | | | | | | | | | | | | | | | | | | | | | | | |
| INSTRUCTIONS: Use typewriter or ball point pen. <u>Please press firmly and print clearly.</u> Please fill in blanks, underline or circle the correct answers. Send top three copies to Kansas Department of Health and Environment, Bureau of Water, Geology Section, 1000 SW Jackson St., Ste. 420, Topeka, Kansas 66612-1367. Telephone: 785/296-5522. Send one to Water Well Owner and retain one for your records. | | | | | | | | | | | | | | | | | | | | | | | | | | | | | | | | |