

LOCATION OF WATER WELL	Fraction	Section Number	Township Number	Range Number
County: <u>Reno</u>	<u>NE 1/4 NE 1/4 NE 1/4</u>	<u>36</u>	<u>T 24 S</u>	<u>R 10 W</u>

Distance and direction from nearest town or city? 2 mi S. and 2 1/2 W of Sylvia  
 Street address of well if located within city? NA

WATER WELL OWNER:  
 FR#, St. Address, Box #: KGS/ GWMD #5  
 City, State, ZIP Code: \_\_\_\_\_  
 Board of Agriculture, Division of Water Resources  
 Application Number: NA

DEPTH OF COMPLETED WELL: 181 ft. Bore Hole Diameter: 9 3/8 in. to \_\_\_\_\_ ft., and \_\_\_\_\_ in. to \_\_\_\_\_  
 Well Water to be used as:  
 1 Domestic 3 Feedlot 6 Oil field water supply 8 Air conditioning 11 Injection well  
 2 Irrigation 4 Industrial 7 Lawn and garden only 9 Dewatering 12 Other (Specify below)  
Research  
 Well's static water level: 109.5 ft. below land surface measured on Jan month 28 day 1983 year  
 Pump Test Data: NA Well water was \_\_\_\_\_ ft. after \_\_\_\_\_ hours pumping \_\_\_\_\_ gpr  
 Est. Yield \_\_\_\_\_ gpm Well water was \_\_\_\_\_ ft. after \_\_\_\_\_ hours pumping \_\_\_\_\_ gpr

TYPE OF BLANK CASING USED:  
 1 Steel 3 RMP (SR) 5 Wrought iron 8 Concrete tile Casing Joints: Glued Clamped \_\_\_\_\_  
2 PVC 4 ABS 6 Asbestos-Cement 9 Other (specify below) Welded \_\_\_\_\_  
 7 Fiberglass Threaded \_\_\_\_\_  
 Blank casing dia: 5.0 in. to 176 ft. Dia \_\_\_\_\_ in. to \_\_\_\_\_ ft. Dia \_\_\_\_\_ in. to \_\_\_\_\_ ft.  
 Casing height above land surface: \_\_\_\_\_ in. weight \_\_\_\_\_ lbs./ft. Wall thickness or gauge No. Schd #40

TYPE OF SCREEN OR PERFORATION MATERIAL:  
 1 Steel 3 Stainless steel 5 Fiberglass 8 RMP (SR) 10 Asbestos-cement 11 Other (specify) \_\_\_\_\_  
 2 Brass 4 Galvanized steel 6 Concrete tile 9 ABS 12 None used (open hole)  
 Screen or Perforation Openings Are:  
 1 Continuous slot 3 Mill slot 5 Gauzed wrapped 8 Saw cut 11 None (open hole)  
 2 Louvered shutter 4 Key punched 6 Wire wrapped 9 Drilled holes  
 7 Torch cut 10 Other (specify) \_\_\_\_\_  
 Screen-Perforation Dia: 5.0 in. to \_\_\_\_\_ ft. Dia \_\_\_\_\_ in. to \_\_\_\_\_ ft. Dia \_\_\_\_\_ in. to \_\_\_\_\_ ft.  
 Screen-Perforated Intervals: From 176 ft. to 181 ft. From \_\_\_\_\_ ft. to \_\_\_\_\_ ft. From \_\_\_\_\_ ft. to \_\_\_\_\_ ft.  
 Gravel Pack Intervals: From 172 ft. to 181 ft. From \_\_\_\_\_ ft. to \_\_\_\_\_ ft. From \_\_\_\_\_ ft. to \_\_\_\_\_ ft.

GROUT MATERIAL: 1 Neat cement 2 Cement grout 3 Bentonite 4 Other \_\_\_\_\_  
 Grouted Intervals: From 72 ft. to 172 ft. From 0 ft. to 10 ft. From \_\_\_\_\_ ft. to \_\_\_\_\_ ft.  
 What is the nearest source of possible contamination: NONE KNOWN  
 1 Septic tank 4 Cess pool 7 Sewage lagoon 10 Fuel storage 14 Abandoned water well  
 2 Sewer lines 5 Seepage pit 8 Feed yard 11 Fertilizer storage 15 Oil well/Gas well  
 3 Lateral lines 6 Pit privy 9 Livestock pens 12 Insecticide storage 16 Other (specify below)  
 13 Watertight sewer lines

Direction from well \_\_\_\_\_ How many feet \_\_\_\_\_? Water Well Disinfected? Yes \_\_\_\_\_ No \_\_\_\_\_  
 Was a chemical/bacteriological sample submitted to Department? Yes \_\_\_\_\_ (No) \_\_\_\_\_ If yes, date sample  
 was submitted \_\_\_\_\_ month \_\_\_\_\_ day \_\_\_\_\_ year: Pump Installed? Yes \_\_\_\_\_ (No) \_\_\_\_\_  
 Yes: Pump Manufacturer's name \_\_\_\_\_ Model No. \_\_\_\_\_ HP \_\_\_\_\_ Volts \_\_\_\_\_  
 Depth of Pump Intake \_\_\_\_\_ ft. Pumps Capacity rated at \_\_\_\_\_ gal./min.  
 Type of pump: 1 Submersible 2 Turbine 3 Jet 4 Centrifugal 5 Reciprocating 6 Other

CONTRACTOR'S OR LANDOWNER'S CERTIFICATION: This water well was (1) constructed, (2) reconstructed, or (3) plugged under my jurisdiction and was  
 completed on Sept month 10 day \_\_\_\_\_ year.  
 and this record is true to the best of my knowledge and belief. Kansas Water Well Contractor's License No. \_\_\_\_\_  
 This Water Well Record was completed on \_\_\_\_\_ month \_\_\_\_\_ day \_\_\_\_\_ year under the business  
 name of 1732 by (signature) \_\_\_\_\_

LOCATE WELL'S LOCATION WITH AN "X" IN SECTION BOX:	FROM	TO	LITHOLOGIC LOG	FROM	TO	LITHOLOGIC LOG
	0	17	clay, sandy, gray and brown <sup>1715</sup>	166	168	white silt stone
	17	85	fine to coarse sand, lenses of gravel <sup>1847</sup>	168	181	red siltstone, green gray hard inclusions
	85	90	clay, light red, caliche zones <sup>1842</sup>			
	90	125	fine to coarse sand, some clay, caliche 90-92 <sup>1607</sup>			
	125	140	clay, light red, sandy, caliche at 138 <sup>1592</sup>			
	140	158 <sup>1581</sup>	clay tan, light red, white caliche, some fine sand <sup>1581</sup>			
LEVATION: <del>1739.6</del>	1580	166	dark red silt stone			

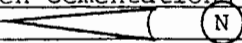
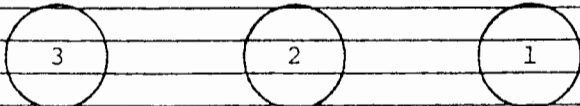
Depth(s) Groundwater Encountered 1. \_\_\_\_\_ ft. 2. \_\_\_\_\_ ft. 3. \_\_\_\_\_ ft. 4. \_\_\_\_\_ ft. (Use a second sheet if needed)  
 INSTRUCTIONS: Use typewriter or ball point pen, please press firmly and PRINT clearly. Please fill in blanks, underline or circle the correct answers. Send top three copies to Kansas Department of Health and Environment, Division of Environment, Water Well Contractors, Topeka, KS 66620. Send one to WATER WELL OWNER and retain one for your records.

BIG BEND GMD#5-KGS  
WATER QUALITY  
OBSERVATION WELL  
NETWORK

SITE NUMBER : 29  
SITE LOCATION: NE NE NE

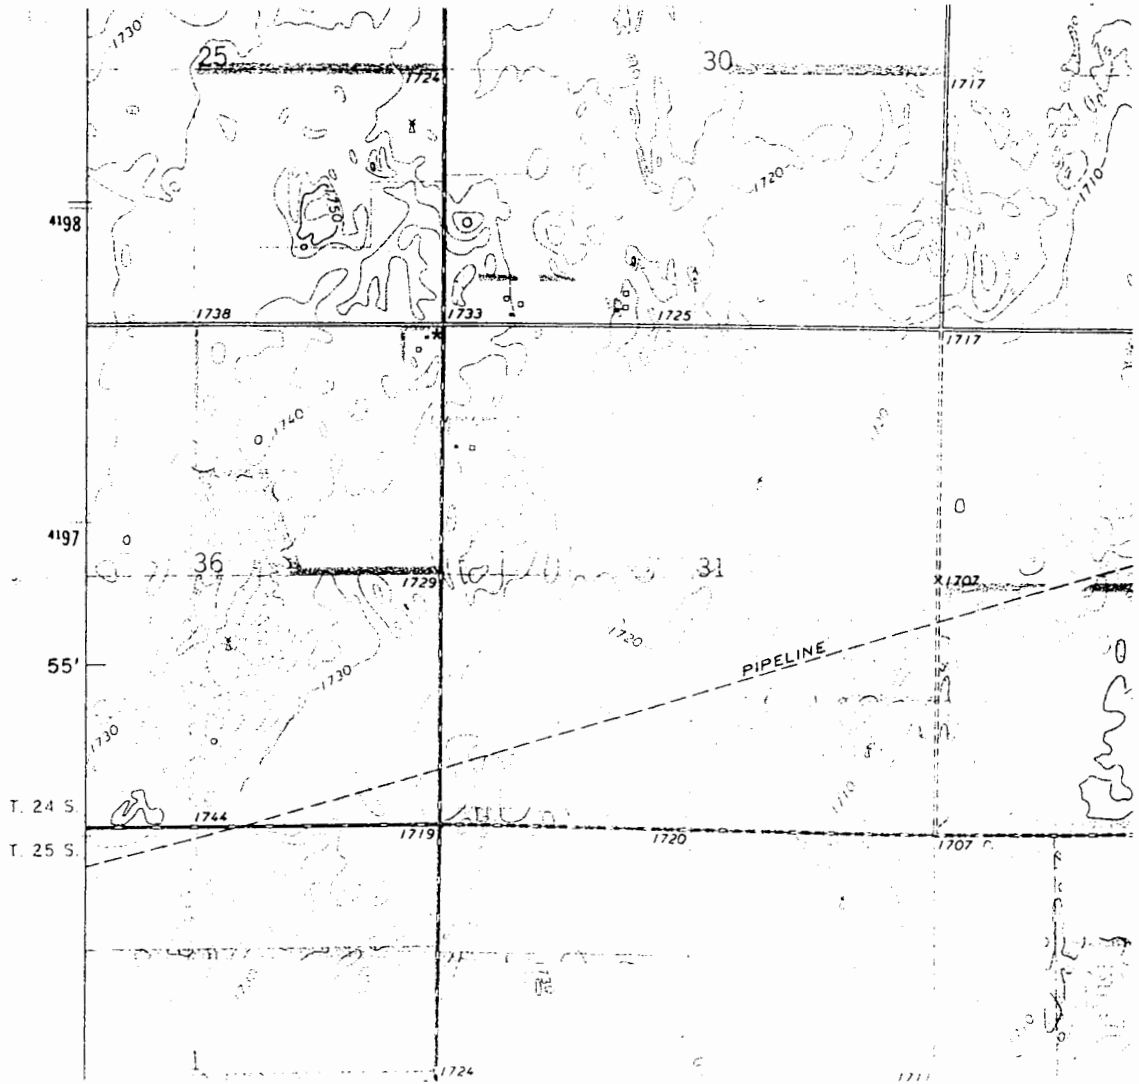
LEGAL LOCATION: 36-24-10W  
COUNTY : RENO

WELL LOG

FROM	TO	LITHOLOGIC LOG	OWNER: DEALY
0	1	topsoil	
1	3	orange & brown clay; some fine sand	
3	4	fine sand, quartz/arkosic (QA); orange clay matrix	
4	6	lt. brown silty clay with some fine QA sand	
6	8	fine QA sand with lt. brown clay	
8	9	light gray clay, streaks of tan	
9	15	tan silty clay, trace caliche, blocky	
15	17	fine & medium QA sand, tan clay matrix	
17	19	fine & medium QA sand	
19	34	fine & medium QA sand, gets coarser with depth	
34	50	fine to coarse QA sand	
50	61	coarse sand to fine gravel, QA	
61	65	fine & medium QA gravel	
65	80	coarse sand, fine/med. QA gravel, a few caliche zones, no clay	
80	85	coarse sand, fine gravel, QA	
85	90	light red clay, some caliche zones, fine QA sand	
90	95	fine QA sand, caliche zones	
95	97	caliche	
97	108	fine & medium QA sand	
108	114	light red clay, some fine sand	
114	125	coarse QA sand, then fine & med. sand with light red clay. clay is increasing with depth	
125	140	lt. red clay, traces of gray, small amt. fine sand; caliche layer at 138'	
140	<del>153</del> /50	tan clay, light red clay, caliche, white clay, fine sand	
150	<del>153</del>	Redbed PERMIAN, dark red siltstone	
166	168	white siltstone	
168	181	Redbed; gray-green cementations between 170-181'	
			
			
62'/3'                      120'/5'                      176'/5'			
TD=65'                      TD=125'                      TD=181'			

SITE NUMBER : 29  
SITE LOCATION : NE NE NE  
LEGAL LOCATION: SEC36 T24S R10W  
COUNTY : RENO

LANDOWNER: CHARLES E. DEALY  
ADDRESS : RURAL ROUTE 1  
SYLVIA, KANSAS 67581  
PHONE NO.: 316-486-3221



WELL LOCATION \*