

1 LOCATION OF WATER WELL:	Fraction	Section Number	Township Number	Range Number
County: Reno	SE$\frac{1}{4}$ SE $\frac{1}{4}$ SW$\frac{1}{4}$	15	T 24 S	R 10 E/W


Distance and direction from nearest town or city street address of well if located within city?

~~Trails West Road, Sylvia, Kansas (2 blocks west of Main)~~

2 WATER WELL OWNER:	George Martin Trust	
RR#, St. Address, Box # :	P.O. Box 7	Board of Agriculture, Division of Water Resources
City, State, ZIP Code :	Sylvia, Ks. 67581	Application Number:

3 LOCATE WELL'S LOCATION WITH AN "X" IN SECTION BOX:

4 DEPTH OF COMPLETED WELL... 20..... ft. ELEVATION: NA

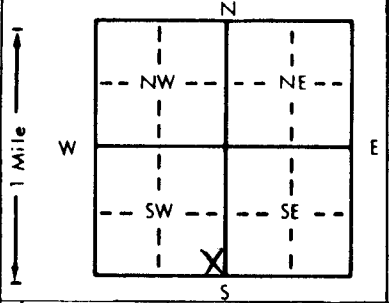

Depth(s) Groundwater Encountered 1. 12 ft. 2. ft. 3. ft.

WELL'S STATIC WATER LEVEL 12.10 ft. below land surface measured on mo/day/yr 01-07-94

Pump test data: Well water was ft. after hours pumping gpm

Est. Yield gpm: Well water was ft. after hours pumping gpm

Bore Hole Diameter, 7 5/8 . . . in. to . . . 20 . . . ft., and . . . in. to . . . ft.

WELL WATER TO BE USED AS:

5 Public water supply	8 Air conditioning	11 Injection well		
1 Domestic	3 Feedlot	6 Oil field water supply	9 Dewatering	12 Other (Specify below)
2 Irrigation	4 Industrial	7 Lawn and garden only	<u>(10)</u> Monitoring well	

Was a chemical/bacteriological sample submitted to Department? Yes No X; If yes, mo/day/yr sample was submitted

Water Well Disinfected? Yes No X

5] TYPE OF BLANK CASING USED:

5 Wrought iron	8 Concrete tile	CASING JOINTS: Glued Clamped
----------------	-----------------	--

1 Steel 3 RMP (SR) 6 Asbestos-Cement 9 Other (specify below) Welded

② PVC 4 ABS 7 Fiberglass Threaded. **X**

Blank casing diameter **2** in. to **10** ft., Dia in. to ft., Dia in. to ft.

Casing height above land surface **0** in., weight lbs./ft. Wall thickness or gauge No. **sch. 40**

TYPE OF SCREEN OR PERFORATION MATERIAL:

1 Steel	3 Stainless steel	5 Fiberglass	8 RMP (SR)	11 Other (specify)
2 Brass	4 Galvanized steel	6 Concrete tile	9 ABS	12 None used (open hole)

SCREEN OR PERFORATION OPENINGS ARE:

1 Continuous slot 3 Mill slot 6 Wire wrapped 9 Drilled holes
2 Louvered shutter 4 Key punched 7 Torch cut 10 Other (specify)

SCREEN-PERFORATED INTERVALS:

	From	ft. to	ft., From	ft. to	ft.
GRAVEL PACK INTERVALS:	From 8	ft. to 20	ft., From	ft. to	ft.
	From	ft. to	ft., From	ft. to	ft.

6] GROUT MATERIAL:

Grout Intervals: From 0 ft. to 6 ft., From 6 ft. to 8 ft., From ft. to ft.

What is the nearest source of possible contamination:

1 Septic tank	4 Lateral lines	7 Pit privy	11 Fuel storage	15 Oil well/Gas well
2 Sewer lines	5 Cess pool	8 Sewage lagoon	12 Fertilizer storage	16 Other (specify below)
3 Watertight sewer lines	6 Seepage pit	9 Feedyard	13 Insecticide storage	

Direction from well?

FROM	TO	LITHOLOGIC LOG	FROM	TO	PLUGGING INTERVALS
------	----	----------------	------	----	--------------------

[illegible]

Site ID 00066536
SMW4-flush mount cover

7. CONTRACTOR'S OR LANDOWNER'S CERTIFICATION: This water well was (1) constructed, (2) reconstructed, or (3) plugged under my jurisdiction and was completed on (mo/day/year) 01-05-94 and this record is true to the best of my knowledge and belief. Kansas Water Well Contractor's License No. 527 This Water Well Record was completed on (mo/day/yr) 01-29-94 under the business name of GeoCore Services, Inc. by (signature) [Signature]