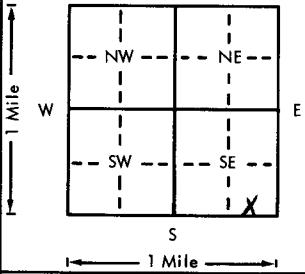


USE TYPEWRITER OR BALL
POINT PEN-PRESS FIRMLY,
PRINT CLEARLY.

WATER WELL RECORD
KSA 82a-1201-1215

Kansas Department of Health and
Environment-Division of Environment
(Water well Contractors)
Topeka, Kansas 66620

1. Location of well:		County <u>Reno</u>	Fraction <u>SE 1/4 SE 1/4 SE 1/4</u>	Section number <u>15</u>	Township number <u>T 24 S</u>	Range number <u>R 10 E/W</u>
2. Distance and direction from nearest town or city: <u>1/2 E Sylvia</u> Street address of well location if in city:				3. Owner of well: <u>George Bemis</u> R.R. or street: <u>3220 1014 St. Box 978</u> City, state, zip code: <u>Great Bend, Ks.</u>		
4. Locate with "X" in section below:		Sketch map:		6. Bore hole dia. <u>29</u> in. Completion date <u>8-11-75</u> Well depth <u>91</u> ft.		
<u>Clay</u>		<u>2</u>		<u>40</u>		10. Screen: Manufacturer's name <u>Bemis</u> Type <u>Steel</u> Dia. <u>16</u> Slot gauge <u>3/16</u> Length <u>20</u> Set between <u>71</u> ft. and <u>91</u> ft. ft. and <u>40</u> ft. Gravel pack? <u>40</u> Size range of material <u>1/2 3/4 3/8</u>
<u>Sand</u>		<u>40</u>		<u>90</u>		11. Static water level: <u>26</u> ft. below land surface Date <u>8-5-75</u> mo./day/yr.
						13. Water sample submitted: <u>Yes</u> No <u>40</u> Date <u>9-19-75</u> mo./day/yr.
18. Elevation:		19. Remarks:		20. Water well contractor's certification: This well was drilled under my jurisdiction and this report is true to the best of my knowledge and belief. <u>Rosenkrantz - Bemis</u> <u>134</u> Business name License No. Address <u>Great Bend, Ks.</u> Signed <u>Tisha Arlison</u> Date <u>9/21/75</u> Authorized representative		

24 100 15 SE SE SE
T R Sec 1/4 1/4 1/4