WATER WELL RECORD Form WWC-5 KSA 82a-1212

1 LOCATION OF WATER WELL: County: STAFFORD | Fraction: W C ¼ N/2 ¼ SE ¼ | Section Number: 24 | Township Number: T 24 S | Range Number: R 11 E/W

Distance and direction from nearest town or city street address of well if located within city?
10-S 5-E OF ELLINWOOD,KS

2 WATER WELL OWNER: HONEY OIL CO. INC
RR#, St. Address, Box # : 401 E. DOUGLAS #505
City, State, ZIP Code : WICHITA,KS. 67202
Board of Agriculture, Division of Water Resources
Application Number: 92-0488

3 LOCATE WELL'S LOCATION WITH AN "X" IN SECTION BOX:

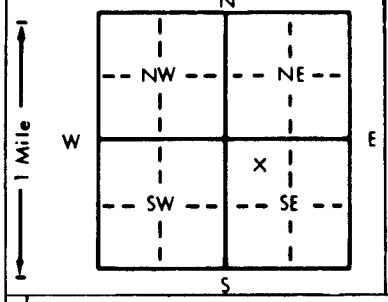

4 DEPTH OF COMPLETED WELL 73 ft. ELEVATION:
Depth(s) Groundwater Encountered 1. ft. 2. ft. 3. ft.
WELL'S STATIC WATER LEVEL 35 ft. below land surface measured on mo/day/yr
Pump test data: Well water was ft. after hours pumping gpm
Est. Yield gpm: Well water was ft. after hours pumping gpm
Bore Hole Diameter 9 in. to ft., and in. to ft.
WELL WATER TO BE USED AS: 1 Domestic 2 Irrigation 3 Feedlot 4 Industrial 5 Public water supply XX6 Oil field water supply 7 Lawn and garden only 8 Air conditioning 9 Dewatering 10 Monitoring well 11 Injection well 12 Other (Specify below)
Was a chemical/bacteriological sample submitted to Department? Yes No X; If yes, mo/day/yr sample was submitted
Water Well Disinfected? Yes X No

5 TYPE OF BLANK CASING USED: XX2 PVC | 1 Steel | 3 RMP (SR) | 4 ABS | 5 Wrought iron | 6 Asbestos-Cement | 7 Fiberglass | 8 Concrete tile | 9 Other (specify below)
CASING JOINTS: Glued X Clamped Welded Threaded
Blank casing diameter 5 in. to 63 ft., Dia in. to ft., Dia in. to ft.
Casing height above land surface 12 in., weight lbs./ft. Wall thickness or gauge No.
TYPE OF SCREEN OR PERFORATION MATERIAL: XX PVC | 1 Steel | 2 Brass | 3 Stainless steel | 4 Galvanized steel | 5 Fiberglass | 6 Concrete tile | 8 RMP (SR) | 9 ABS | 10 Asbestos-cement | 11 Other (specify) | 12 None used (open hole)
SCREEN OR PERFORATION OPENINGS ARE: XX3 Mill slot | 1 Continuous slot | 2 Louvered shutter | 4 Key punched | 5 Gauzed wrapped | 6 Wire wrapped | 7 Torch cut | 8 Saw cut | 9 Drilled holes | 10 Other (specify) | 11 None (open hole)
SCREEN-PERFORATED INTERVALS: From 73 ft. to 83 ft., From ft. to ft.
From ft. to ft., From ft. to ft.
GRAVEL PACK INTERVALS: From 20 ft. to 83 ft., From ft. to ft.
From ft. to ft., From ft. to ft.

6 GROUT MATERIAL: 1 Neat cement 2 Cement grout XX3 Bentonite 4 Other
Grout Intervals: From 0 ft. to 20 ft., From ft. to ft., From ft. to ft.
What is the nearest source of possible contamination:
1 Septic tank 2 Sewer lines 3 Watertight sewer lines 4 Lateral lines 5 Cess pool 6 Seepage pit 7 Pit privy 8 Sewage lagoon 9 Feedyard 10 Livestock pens 11 Fuel storage 12 Fertilizer storage 13 Insecticide storage 14 Abandoned water well 15 Oil well/Gas well 16 Other (specify below) NONE
Direction from well? How many feet?

FROM	TO	LITHOLOGIC LOG	FROM	TO	PLUGGING INTERVALS
0	3	TOP SOIL			
3	40	CLAY			
40	73	GRAVEL			

7 CONTRACTOR'S OR LANDOWNER'S CERTIFICATION: This water well was XX constructed, (2) reconstructed, or (3) plugged under my jurisdiction and was completed on (mo/day/year) 12-21-93 and this record is true to the best of my knowledge and belief. Kansas Water Well Contractor's License No. 462-B. This Water Well Record was completed on (mo/day/yr) 4-2-93
under the business name of SAM'S WATER WELL SERVICE by (signature) Lora Raupern

INSTRUCTIONS: Use typewriter or ball point pen. *PLEASE PRESS FIRMLY* and *PRINT* clearly. Please fill in blanks, underline or circle the correct answers. Send top three copies to Kansas Department of Health and Environment, Bureau of Water, Topeka, Kansas 66620-0001. Telephone: 913-296-5545. Send one to WATER WELL OWNER and retain one for your records.

OFFICE USE ONLY T R E/W SEC. ¼ ¼ ¼