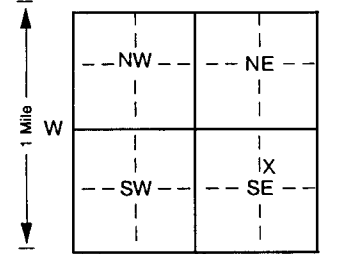


|   |  |   |  |                |  |                 |  |              |  |
|---|--|---|--|----------------|--|-----------------|--|--------------|--|
| 1 LOCATION OF WATER WELL:   |  | Fraction   |  | Section Number |  | Township Number |  | Range Number |  |
| County: Stafford   |  | SW 1/4 NE 1/4 SE 1/4                                                                                         |  | 26             |  | T 24 S          |  | R 12 E       |  |
| Distance and direction from nearest town or city street address of well if located within city?<br>Approximately 1 3/4 miles south of Stafford   |  |   |  |                |  |                 |  |              |  |
| 2 WATER WELL OWNER: James Dickson<br>RR#, St. Address, Box # : Route 1 - Box 67<br>City, State, ZIP Code : Stafford, KS 67578<br>Board of Agriculture, Division of Water Resources<br>Application Number: 41,377   |  |   |  |                |  |                 |  |              |  |
| 3 LOCATE WELL'S LOCATION WITH AN "X" IN SECTION BOX:   |  | 4 DEPTH OF COMPLETED WELL 61 ft. ELEVATION: unknown                                                          |  |                |  |                 |  |              |  |
|   |  | Depth(s) Groundwater Encountered 1 ft. 2 ft. 3 ft. ft.                                                       |  |                |  |                 |  |              |  |
|   |  | WELL'S STATIC WATER LEVEL 26 ft. below land surface measured on mo/day/yr 12-5-00                            |  |                |  |                 |  |              |  |
|   |  | Pump test data: Well water was not checked ft. after hours pumping gpm                                       |  |                |  |                 |  |              |  |
|   |  | Est. Yield unknown gpm: Well water was ft. after hours pumping gpm                                           |  |                |  |                 |  |              |  |
|   |  | Bore Hole Diameter 24 in. to 60 ft., and in. to ft.                                                          |  |                |  |                 |  |              |  |
|   |  | WELL WATER TO BE USED AS: 5 Public water supply 8 Air conditioning 11 Injection well                         |  |                |  |                 |  |              |  |
|   |  | 1 Domestic 3 Feedlot 6 Oil field water supply 9 Dewatering 12 Other (specify below)                          |  |                |  |                 |  |              |  |
|   |  | 2 Irrigation 4 Industrial 7 Domestic (lawn & garden) 10 Monitoring well                                      |  |                |  |                 |  |              |  |
|   |  | Was a chemical/bacteriological sample submitted to Department? Yes No If yes, mo/day/yr sample was submitted |  |                |  |                 |  |              |  |
|   |  | Water Well Disinfected? Yes No                                                                               |  |                |  |                 |  |              |  |
| 5 TYPE OF BLANK CASING USED: 5 Wrought iron 8 Concrete tile CASING JOINTS: Glued Clamped   |  |   |  |                |  |                 |  |              |  |
| 1 Steel 3 RMP (SR) 6 Asbestos-Cement 9 Other (specify below) Welded   |  |   |  |                |  |                 |  |              |  |
| 2 PVC 4 ABS 7 Fiberglass Threaded   |  |   |  |                |  |                 |  |              |  |
| Blank casing diameter 10 in. to 44 ft., Dia in. to ft., Dia in. to ft.   |  |   |  |                |  |                 |  |              |  |
| Casing height above land surface 12 in., weight 7.80 lbs./ft. Wall thickness or gauge No .365   |  |   |  |                |  |                 |  |              |  |
| TYPE OF SCREEN OR PERFORATION MATERIAL: 7 PVC 10 Asbestos-cement   |  |   |  |                |  |                 |  |              |  |
| 1 Steel 3 Stainless steel 5 Fiberglass 8 RMP (SR) 11 Other (specify)   |  |   |  |                |  |                 |  |              |  |
| 2 Brass 4 Galvanized steel 6 Concrete tile 9 ABS 12 None used (open hole)   |  |   |  |                |  |                 |  |              |  |
| SCREEN OR PERFORATION OPENINGS ARE: 5 Gauzed wrapped 8 Saw cut 11 None (open hole)   |  |   |  |                |  |                 |  |              |  |
| 1 Continuous slot 3 Mill slot 6 Wire wrapped 9 Drilled holes   |  |   |  |                |  |                 |  |              |  |
| 2 Louvered shutter 4 Key punched 7 Torch cut 10 Other (specify) Bridge Slot   |  |   |  |                |  |                 |  |              |  |
| SCREEN-PERFORATED INTERVALS: From 44 ft. to 60 ft., From ft. to ft.   |  |   |  |                |  |                 |  |              |  |
| GRAVEL PACK INTERVALS: From 40 ft. to 60 ft., From ft. to ft.   |  |   |  |                |  |                 |  |              |  |
| 6 GROUT MATERIAL: 1 Neat cement 2 Cement grout 3 Bentonite Compacted Soil 4 Other Road Sand   |  |   |  |                |  |                 |  |              |  |
| Grout intervals: From 3 ft. to 25 ft., From 0 ft. to 3 ft., From 25 ft. to 40 ft.   |  |   |  |                |  |                 |  |              |  |
| What is the nearest source of possible contamination: 10 Livestock pens 14 Abandoned water well   |  |   |  |                |  |                 |  |              |  |
| 1 Septic tank 4 Lateral lines 7 Pit privy 11 Fuel storage 15 Oil well/Gas well   |  |   |  |                |  |                 |  |              |  |
| 2 Sewer lines 5 Cess pool 8 Sewage lagoon 12 Fertilizer storage 16 Other (specify below)   |  |   |  |                |  |                 |  |              |  |
| 3 Watertight sewer lines 6 Seepage pit 9 Feedyard 13 Insecticide storage None known   |  |   |  |                |  |                 |  |              |  |
| Direction from well? How many feet?   |  |   |  |                |  |                 |  |              |  |
| FROM TO LITHOLOGIC LOG FROM TO PLUGGING INTERVALS   |  |   |  |                |  |                 |  |              |  |
| 0 4 Topsoil   |  |   |  |                |  |                 |  |              |  |
| 4 9 Clay, brown   |  |   |  |                |  |                 |  |              |  |
| 9 22 Clay, gray   |  |   |  |                |  |                 |  |              |  |
| 22 38 Clay, brown   |  |   |  |                |  |                 |  |              |  |
| 38 59 Sand and gravel, fine, medium, coarse   |  |   |  |                |  |                 |  |              |  |
| 59 60 Clay   |  |   |  |                |  |                 |  |              |  |
| 7 CONTRACTOR'S OR LANDOWNER'S CERTIFICATION: This water well was (1) constructed (2) reconstructed or (3) plugged under my jurisdiction and was completed on (mo/day/year) 12-5-00 and this record is true to the best of my knowledge and belief. Kansas Water Well Contractor's License No 185 This Water Well Record was completed on (mo/day/yr) 12-8-00 under the business name of Clarke Well & Equipment, Inc. by (signature) |  |   |  |                |  |                 |  |              |  |
| INSTRUCTIONS: Use typewriter or ball point pen. PLEASE PRESS FIRMLY and PRINT clearly. Please fill in blanks, underline or circle the correct answers. Send top three copies to Kansas Department of Health and Environment, Bureau of Water, Topeka, Kansas 66620-0001. Telephone 785-298-5524. Send one to WATER WELL OWNER and retain one for your records. Fee of \$5.00 for each constructed well.                              |  |   |  |                |  |                 |  |              |  |