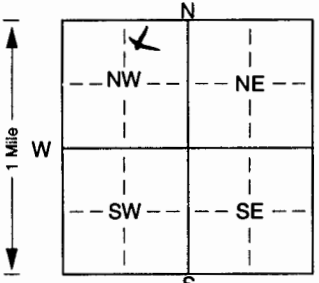


1 LOCATION OF WATER WELL:		Fraction	Section Number	Township Number	Range Number
County: <u>Stafford</u>		<u>NW 1/4 NE 1/4 NW 1/4</u>	<u>24</u>	<u>T 24 S</u>	<u>R 12 E</u>
Distance and direction from nearest town or city street address of well if located within city? <u>443 Martin Stafford KS</u>					
2 WATER WELL OWNER: <u>Jay Ray 402 Smith Loop</u>					
RR#, St. Address, Box # : <u>443 Martin St</u>				Board of Agriculture, Division of Water Resources	
City, State, ZIP Code : <u>Stafford KS 67578</u>				Application Number:	
3 LOCATE WELL'S LOCATION WITH AN "X" IN SECTION BOX:		4 DEPTH OF COMPLETED WELL: <u>21</u> ft. ELEVATION:			
		Depth(s) Groundwater Encountered 1. ft. 2. ft. 3. ft. WELL'S STATIC WATER LEVEL ft. below land surface measured on mo/day/yr Pump test data: Well water was ft. after hours pumping gpm Est. Yield gpm: Well water was ft. after hours pumping gpm Bore Hole Diameter. <u>7 1/4</u> in. to <u>21</u> ft., and in. to ft. WELL WATER TO BE USED AS: 5 Public water supply 8 Air conditioning 11 Injection well 1 Domestic 3 Feedlot 6 Oil field water supply 9 Dewatering 12 Other (Specify below) 2 Irrigation 4 Industrial 7 Domestic (lawn & garden) ☒ Monitoring well Was a chemical/bacteriological sample submitted to Department? Yes. No. <u> </u> ; If yes, mo/day/yr sample was submitted Water Well Disinfected? Yes No <u> </u>			
5 TYPE OF BLANK CASING USED:					
1 Steel 3 RMP (SR) 5 Wrought iron 8 Concrete tile CASING JOINTS: Glued. Clamped.		9 Other (specify below) Welded.			
☒ PVC 4 ABS 7 Fiberglass Threaded. ☒					
Blank casing diameter in. to ft., Dia in. to ft., Dia in. to ft.					
Casing height above land surface. in., weight <u>Sched 40</u> lbs./ft. Wall thickness or gauge No.					
TYPE OF SCREEN OR PERFORATION MATERIAL:					
1 Steel 3 Stainless steel 5 Fiberglass 9 PVC 10 Asbestos-cement		8 RMP (SR) 11 Other (specify)			
2 Brass 4 Galvanized steel 6 Concrete tile 9 ABS 12 None used (open hole)					
SCREEN OR PERFORATION OPENINGS ARE:					
1 Continuous slot ☒ Mill slot <u>0.10</u> 5 Gauzed wrapped 8 Saw cut 11 None (open hole)		6 Wire wrapped 9 Drilled holes			
2 Louvered shutter 4 Key punched 7 Torch cut 10 Other (specify) ft.					
SCREEN-PERFORATED INTERVALS: From <u>21</u> ft. to <u>11</u> ft., From ft. to ft.					
GRAVEL PACK INTERVALS: From <u>21</u> ft. to <u>7</u> ft., From ft. to ft.					
6 GROUT MATERIAL: 1 Neat cement 2 Cement grout ☒ Bentonite 4 Other					
Grout Intervals: From ft. to <u>7.5</u> ft., From <u>7</u> ft. to <u>1</u> ft., From ft. to ft.					
What is the nearest source of possible contamination:					
1 Septic tank 4 Lateral lines 7 Pit privy ☒ Fuel storage 15 Oil well/Gas well		10 Livestock pens 14 Abandoned water well			
2 Sewer lines 5 Cess pool 8 Sewage lagoon 12 Fertilizer storage 16 Other (specify below)		3 Watertight sewer lines 6 Seepage pit 9 Feedyard 13 Insecticide storage <u>FORMER FILL</u>			
Direction from well? ☒ How many feet? <u>0</u>					
FROM	TO	LITHOLOGIC LOG	FROM	TO	PLUGGING INTERVALS
<u>0</u>	<u>1.5</u>	<u>Gravelly Rock Clay Fill</u>			
<u>1.5</u>	<u>12</u>	<u>Pea Gravel Fill</u>			
<u>12</u>	<u>17</u>	<u>Clayey Sand Brn Strong Acid odor</u>			
<u>17</u>	<u>21</u>	<u>Clayey Sand Brn tan</u>			
7 CONTRACTOR'S OR LANDOWNER'S CERTIFICATION: This water well was <u>6</u> constructed, (2) reconstructed, or (3) plugged under my jurisdiction and was completed on (mo/day/year) <u>1-23-01</u> and this record is true to the best of my knowledge and belief. Kansas Water Well Contractor's Licence No. <u>575</u> This Water Well Record was completed on (mo/day/yr) <u>2-27-01</u> under the business name of <u>FUNKIE DRILLING SERVICE INC</u> by (signature) <u>[Signature]</u>					
INSTRUCTIONS: Use typewriter or ball point pen. PLEASE PRESS FIRMLY and PRINT clearly. Please fill in blanks, underline or circle the correct answers. Send top three copies to Kansas Department of Health and Environment, Bureau of Water, Topeka, Kansas 66620-0001. Telephone 785-296-5524. Send one to WATER WELL OWNER and retain one for your records. Fee of \$5.00 for each constructed well.					