

CORRECTION TO WATER WELL RECORD (WWC-5)

The following correction(s) was made to the attached WWC-5 log in order to rectify lacking or incorrect information.

Fraction (1/4 1/4 1/4) Section-Township-Range changed:

listed as SW SE SW, 13-24S-2W

changed to SW SE SW, 13-24S-12W

Other changes: Initial statements: _____

Changed to: _____

Comments: _____

verification method: Well owner's address, legal description, position on plat map, and Stafford 1:24,000 topo. map.

initials: ORA date: 1/31/2003

submitted by: Kansas Geological Survey, Data Resources Library, 1930 Constant Ave., Lawrence, KS 66047-3726
to: Kansas Dept of Health & Environment Bureau of Water Industrial Programs, Bldg 283, Forbes Field, KS 66620

2 WATER WELL OWNER: Handi Serv		
RR#, St. Address, Box #	P. O. Box 340	Board of Agriculture, Division of Water Resources
City, State, ZIP Code	Stafford, Ks 67578	Application Number:
	MW 3	

4 DEPTH OF COMPLETED WELL 21 ft. ELEVATION: _____

Depth(s) Groundwater Encountered 1 _____ ft. 2 _____ ft. 3 _____ ft.

WELL'S STATIC WATER LEVEL 15 ft. below land surface measured on mo/day/yr _____


Pump test data: Well water was _____ ft. after _____ hours pumping _____ gpm

Est. Yield _____ gpm: Well water was _____ ft. after _____ hours pumping _____ gpm

Bore Hole Diameter 8 in. to 21 ft. and _____ in. to _____ ft.

WELL WATER TO BE USED AS:

1 Domestic	3 Feed lot	6 Oil field water supply	8 Air conditioning	11 Injection well
2 Irrigation	4 Industrial	7 Lawn and garden (domestic)	9 Dewatering	12 Other (Specify below)
			<u>10</u> Monitoring well	

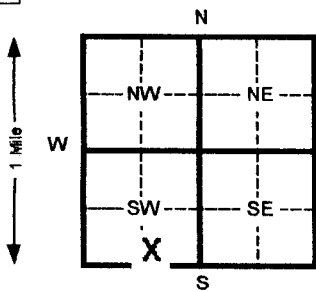

5 TYPE OF BLANK CASING USED:		5 Wrought Iron	8 Concrete tile	CASING JOINTS: Glued _____ Clamped _____	
1 Steel	3 RMP (SR)	6 Asbestos-Cement	9 Other (specify below)	Welded _____	
2 PVC	4 ABS	7 Fiberglass		Threaded X	
Blank casing diameter 2 in. to 11 ft., Dia		in. to _____ ft., Dia		in. to _____ ft.	
Casing height above land surface 0 in., weight .716 lbs./ft.		Wall thickness or gauge No. .154			

TYPE OF SCREEN OR PERFORATION MATERIAL:				
1 Steel	3 Stainless steel	5 Fiberglass	7 PVC	10 Asbestos-cement
2 Brass	4 Galvanized steel	6 Concrete tile	8 RMP (SR)	11 Other (specify)
			9 ABS	12 None used (open hole)

SCREEN OR PERFORATION OPENINGS ARE:

1 Continuous slot	3 Mill slot	5 Gauzed wrapped	8 Saw cut	11 None (open hole)
2 Louvered shutter	4 Key punched	6 Wire wrapped	9 Drilled holes	
		7 Torch cut	10 Other (specify)	

SCREEN-PERFORATED INTERVALS:	From	11	ft. to	21	ft. From		ft. to		ft.
	From		ft. to		ft. From		ft. to		ft.
GRAVEL PACK INTERVALS:	From	10	ft. to	21	ft. From		ft. to		ft.
	From		ft. to		ft. From		ft. to		ft.

6 GROUT MATERIAL:		1 Neat cement		2 Cement grout		3 Bentonite		4 Other	
Grout Intervals		From	0	ft. to	2	ft. From	2	ft. to	10
What is the nearest source of possible contamination:									
1	Septic tank	4	Lateral lines	7	Pit privy	10	Livestock pens	14	Abandoned water well
2	Sewer lines	5	Cess pool	8	Sewage lagoon	11	Fuel storage	15	Oil well/ Gas well
3	Watertight sewer lines	6	Seepage pit	9	Feedyard	12	Fertilizer storage	16	Other (specify below)
						13	Insecticide storage	Contaminated site	

[illegible]

7 CONTRACTOR'S OR LANDOWNER'S CERTIFICATION: This water well was (1) constructed, (2) reconstructed, or (3) plugged under my jurisdiction and was completed on (mo/day/yr) 3-1-02 and this record is true to the best of my knowledge and belief. Kansas Water Well Contractor's License No. 554 This Water Well Record was completed on (mo/day/yr) 5-21-02 under the business name of Woofert Pump and Well Inc. by (signature) [Signature]

INSTRUCTIONS: Please fill in blanks and circle the correct answers. Send three copies to Kansas Department of Health and Environment, Bureau of Water, Topeka, Kansas 66620-0001. Telephone: 913-296-5545. Send one to WATER WELL OWNER and retain one for your records.