


1 LOCATION OF WATER WELL:		Fraction	Section Number		Township Number		Range Number	
County:	Stafford	SW $\frac{1}{4}$ SE $\frac{1}{4}$ SW $\frac{1}{4}$	13		T	24	S	R 12
Distance and direction from nearest town or city street address of well if located within city?								

2	WATER WELL OWNER:	Frank Roush		
	RR#, St. Address, Box #	PO Box 51	U1-093-11661	Board of Agriculture, Division of Water Resources
	City, State, ZIP Code	Murdoch, KS 67111	MW 6 Handi-Serv	Application Number: "

3	LOCATE WELL'S LOCATON WITH AN "X" IN SECTION BOX:
---	---

4 DEPTH OF COMPLETED WELL 22 ft. ELEVATION: _____

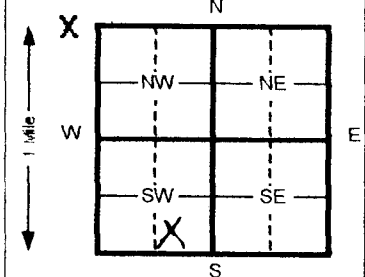

DEPTH OF COMPLETED WELL		22		ft. ELEVATION:	
Depth(s) Groundwater Encountered	1	ft	2	ft	3
WELL'S STATIC WATER LEVEL		na			
		ft. below land surface measured on mo/day/yr			
Pump test data:	Well water was		ft. after	hours pumping	gpm
Est. Yield	gpm:	Well water was	ft. after	hours pumping	gpm
Bore Hole Diameter	8	in. to	22	ft. and	in. to
WELL WATER TO BE USED AS:		5 Public water supply	8 Air conditioning	11 Injection well	
1 Domestic	3 Feed lot	6 Oil field water supply	9 Dewatering	12 Other (Specify below)	
2 Irrigation	4 Industrial	7 Lawn and garden (domestic)	10	Monitoring well	
Was a chemical/bacteriological sample submitted to Department? Yes					
No ☒ If yes, mo/day/yr sample was submitted					
Water Well Disinfected? Yes					
No ☒					

5 TYPE OF BLANK CASING USED:		3 Wrought iron	8 Concrete tile	CASING JOINTS: Glued	Clamped
1 Steel	3 RMP (SR)	6 Asbestos-Cement	9 Other (specify below)	Welded	
2 PVC	4 ABS	7 Fiberglass		Threaded	X
Blank casing diameter	2 in. to 12	ft. Dia	in. to	ft. Dia	in. to
Casing height above land surface	0 in., weight	.716	lbs./ft. Wall thickness or gauge No.	.154	
TYPE OF SCREEN OR PERFORATION MATERIAL:		7 PVC	10 Asbestos-cement		
1 Steel	3 Stainless steel	5 Fiberglass	8 RMP (SR)	11 Other (specify)	
2 Brass	4 Galvanized steel	6 Concrete tile	9 ABS	12 None used (open hole)	
SCREEN OR PERFORATION OPENINGS ARE:		5 Gauzed wrapped	8 Saw cut	11 None (open hole)	
1 Continuous slot	3 Mill slot	6 Wire wrapped	9 Drilled holes		
2 Louvered shutter	4 Key punched	7 Torch cut	10 Other (specify)		
SCREEN-PERFORATED INTERVALS:		From 12	ft. to 22	ft. From	ft. to
		From	ft. to	ft. From	ft. to
GRAVEL PACK INTERVALS:		From 10	ft. to 22	ft. From	ft. to
		From	ft. to	ft. From	ft. to

6 GROUT MATERIAL:		1 Neat cement	2 Cement grout	3 Bentonite	4 Other			
Grout Intervals	From	0	ft. to	2	ft. From	10	ft. to	ft.
What is the nearest source of possible contamination:								
1 Septic tank	4 Lateral lines	7 Pit privy	10 Livestock pens	14 Abandoned water well				
2 Sewer lines	5 Cess pool	8 Sewage lagoon	11 Fuel storage	15 Oil well/ Gas well				
3 Watertight sewer lines	6 Seepage pit	9 Feedyard	12 Fertilizer storage	16 Other (specify below)				
			13 Insecticide storage	Contaminated Site				

[illegible]

7 CONTRACTOR'S OR LANDOWNER'S CERTIFICATION: This water well was (1) constructed, (2) reconstructed, or (3) plugged under my jurisdiction and was completed on (mo/day/yr) 08/07/02 and this record is true to the best of my knowledge and belief. Kansas Water Well Contractor's License No. 554 This Water Well Record was completed on (mo/day/yr) 10/04/02 under the business name of Woofter Pump & Well, Inc. by (signature) [Signature]

INSTRUCTIONS: Please fill in blanks and circle the correct answers. Send three copies to Kansas Department of Health and Environment, Bureau of Water, Topeka, Kansas 66620-0001. Telephone: 913-296-5545. Send one to WATER WELL OWNER and retain one for your records.