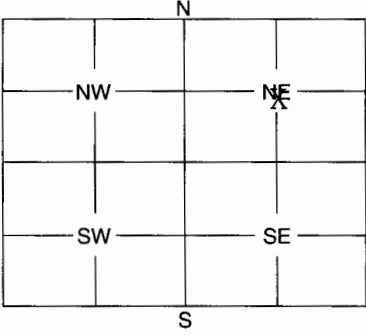


1	LOCATION OF WATER WELL:	Fraction	Section	Number	Township	Number	Range	Number																								
	County: <u>Stafford</u>	$\frac{1}{4}$ NC $\frac{1}{4}$ NE $\frac{1}{4}$		<u>6</u>		<u>24</u>		<u>12</u> <u>EW</u>																								
Distance and direction from nearest town or city street address of well if located within city? <u>3 3/4 East of St. John</u>																																
2	WATER WELL OWNER: <u>Turner KANKY Farms</u> P.O. Box 460 RR #, St. Address, Box #: <u>Great Bend, Ks. 67530</u> City, State, ZIP Code : <u>Great Bend, Ks. 67530</u>																															
Board of Agriculture, Division of Water Resources Application Number: <u>24710</u>																																
3	MARK WELL'S LOCATION WITH AN "X" IN SECTION BOX:		4 DEPTH OF WELL <u>96</u> ft. WELL'S STATIC WATER LEVEL <u>26</u> ft. WELL WAS USED AS: <table style="width:100%; border: none;"> <tr> <td style="width:33%;">1 Domestic</td> <td style="width:33%;">5 Public Water Supply</td> <td style="width:33%;">9 Dewatering</td> </tr> <tr> <td>2 Irrigation</td> <td>6 Oil Field Water Supply</td> <td>10 Monitoring Well</td> </tr> <tr> <td>3 Feedlot</td> <td>7 Domestic (Lawn & Garden)</td> <td>11 Injection Well</td> </tr> <tr> <td>4 Industrial</td> <td>8 Air Conditioning</td> <td>12 Other</td> </tr> </table>						1 Domestic	5 Public Water Supply	9 Dewatering	2 Irrigation	6 Oil Field Water Supply	10 Monitoring Well	3 Feedlot	7 Domestic (Lawn & Garden)	11 Injection Well	4 Industrial	8 Air Conditioning	12 Other												
1 Domestic	5 Public Water Supply	9 Dewatering																														
2 Irrigation	6 Oil Field Water Supply	10 Monitoring Well																														
3 Feedlot	7 Domestic (Lawn & Garden)	11 Injection Well																														
4 Industrial	8 Air Conditioning	12 Other																														
			Was a chemical / bacteriological sample submitted to Department? Yes No <u>X</u> If yes, mo/day/yr sample was submitted Water Well Disinfected: Yes <u>HTH</u> No																													
5	TYPE OF BLANK CASING USED:																															
1 Steel 3 RMP (SR) 5 Wrought 7 Fiberglass 9 Other (Specify below) 2 PVC 4 ABS 6 Asbestos-Cement 8 Concrete Tile																																
Blank casing diameter <u>16</u> in. Was casing pulled? Yes No <u>X</u> If yes, how much Casing height above or below land surface <u>0</u> in.																																
6	GROUT PLUG MATERIAL: 1 <u>Neat cement</u> 2 Cement grout 3 Bentonite 4 Other Grout Plug Intervals: From <u>26</u> ft. to <u>0</u> ft., From ft. to ft., From to ft.																															
What is the nearest source of possible contamination: <table style="width:100%; border: none;"> <tr> <td style="width:33%;">1 Septic tank</td> <td style="width:33%;">6 Seepage pit</td> <td style="width:33%;">11 Fuel storage</td> </tr> <tr> <td>2 Sewer lines</td> <td>7 Pit privy</td> <td>12 Fertilizer storage</td> </tr> <tr> <td>3 Watertight sewer lines</td> <td>8 Sewage lagoon</td> <td>13 Insecticide storage</td> </tr> <tr> <td>4 Lateral lines</td> <td>9 Feedyard</td> <td>14 Abandoned water well</td> </tr> <tr> <td>5 Cess pool</td> <td>10 Livestock pens</td> <td>15 Oil well/Gas well</td> </tr> <tr> <td colspan="3">16 Other (specify below) <u>None</u></td> </tr> </table>									1 Septic tank	6 Seepage pit	11 Fuel storage	2 Sewer lines	7 Pit privy	12 Fertilizer storage	3 Watertight sewer lines	8 Sewage lagoon	13 Insecticide storage	4 Lateral lines	9 Feedyard	14 Abandoned water well	5 Cess pool	10 Livestock pens	15 Oil well/Gas well	16 Other (specify below) <u>None</u>								
1 Septic tank	6 Seepage pit	11 Fuel storage																														
2 Sewer lines	7 Pit privy	12 Fertilizer storage																														
3 Watertight sewer lines	8 Sewage lagoon	13 Insecticide storage																														
4 Lateral lines	9 Feedyard	14 Abandoned water well																														
5 Cess pool	10 Livestock pens	15 Oil well/Gas well																														
16 Other (specify below) <u>None</u>																																
Direction from well? How many feet?																																
<table border="1" style="width:100%; border-collapse: collapse;"> <thead> <tr> <th style="width:10%;">FROM</th> <th style="width:10%;">TO</th> <th style="width:80%;">PLUGGING MATERIALS</th> </tr> </thead> <tbody> <tr> <td style="text-align: center;">96</td> <td style="text-align: center;">26</td> <td><u>Chlorinated gravel</u></td> </tr> <tr> <td style="text-align: center;">26</td> <td style="text-align: center;">0</td> <td><u>Cement</u></td> </tr> <tr><td> </td><td> </td><td> </td></tr> <tr><td> </td><td> </td><td> </td></tr> <tr><td> </td><td> </td><td> </td></tr> <tr><td> </td><td> </td><td> </td></tr> <tr><td> </td><td> </td><td> </td></tr> </tbody> </table>									FROM	TO	PLUGGING MATERIALS	96	26	<u>Chlorinated gravel</u>	26	0	<u>Cement</u>															
FROM	TO	PLUGGING MATERIALS																														
96	26	<u>Chlorinated gravel</u>																														
26	0	<u>Cement</u>																														
7	CONTRACTOR'S OF LANDOWNER'S CERTIFICATION: This water well was plugged under my jurisdiction and was completed on (mo/day/year) <u>1-19-06</u> and this record is true to the best of my knowledge and belief. Kansas Water Well Contractor's License No. <u>134</u> This Water Well Record was completed on (mo/day/year) <u>2-13-06</u> under the business name of <u>Rosencrantz- Bemis</u> by (signature) <u>[Signature]</u>																															

INSTRUCTIONS: Use typewriter or ball point pen. Please press firmly and print clearly. Please fill in blanks, underline or circle the correct answers. Send top three copies to Kansas Department of Health and Environment, Bureau of Water, Geology Section, 1000 SW Jackson St., Ste. 420, Topeka, Kansas 66612-1367. Telephone: 785/296-5522. Send one to Water Well Owner and retain one for your records.