

Corrected

WATER WELL PLUGGING RECORD

Form WWC-5P

KSA 82a-1212


ID No.

AS-1

1 LOCATION OF WATER WELL: County: <u>Stafford</u>	Fraction <u>SW 1/4 SE 1/4 SW 1/4</u>	Section Number <u>13</u>	Township Number <u>24 S</u>	Range Number <u>12W</u>
--	---	-----------------------------	--------------------------------	----------------------------

Distance and direction from nearest town or city street address of well if located within city?
400 East Marlin, Stafford, Kansas

2 WATER WELL OWNER: Frank Roush
 RR#, St. Address, Box # PO Box 51
 City, State, ZIP Code Murdoch, KS 67111
 Board of Agriculture, Division of Water Resources
 Application Number:

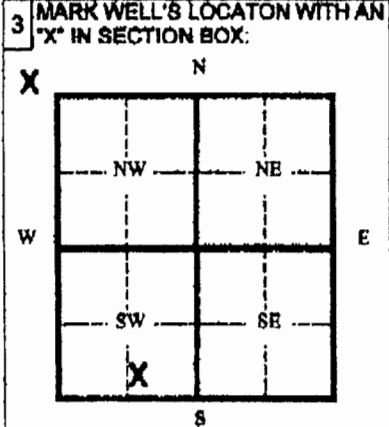

4 DEPTH OF WELL 27.5 ft.
 WELL'S STATIC WATER LEVEL 16.08 ft.
 WELL WAS USED AS:
 1 Domestic 5 Public Water Supply 9 Dewatering
 2 Irrigation 8 Oil Field Water Supply 10 Monitoring Well
 3 Feedlot 7 Lawn and Garden (domestic) 11 Injection Well
 4 Industrial 8 Air Conditioning 12 Other _____

Was a chemical/bacteriological sample submitted to Department? Yes ___ No ___
 If yes, mo/day/yr sample was submitted _____
 Water Well Disinfected: Yes ___ No ___

5 TYPE OF CASING USED:
 1 Steel 3 RMP (SR) 5 Wrought 7 Fiberglass 9 Other (specify below)
 2 PVC 4 ABC 6 Asbestos-Cement 8 Concrete Tile

Blank casing diameter 2 in. Was casing pulled? Yes No ___ If yes, how much removed 3 ft.
 Casing height above or below land surface -36 in.

6 GROUT PLUG MATERIAL: 1 Neat cement 2 Cement grout 3 Bentonite 4 Other _____

Grout Plug Intervals From 0 ft. to 27.5 ft. From _____ ft. to _____ ft. From _____ ft. to _____ ft.

What is the nearest source of possible contamination:
 1 Septic tank 6 Seepage pit 11 Fuel storage 16 Other (specify below)
 2 Sewer lines 7 Pit privy 12 Fertilizer storage
 3 Watertight sewer lines 8 Sewage lagoon 13 Insecticide storage
 4 Lateral lines 9 Feedyard 14 Abandoned water well
 5 Cess Pool 10 Livestock pens 15 Oil well/ Gas well

Direction from well? _____ How many feet? _____

FROM	TO	CODE	PLUGGING MATERIALS
0	27.5		Bentonite grout

RECEIVED
 JAN 08 2009
BUREAU OF WATER

7 CONTRACTOR'S OR LANDOWNER'S CERTIFICATION: This water well was plugged under my jurisdiction and was completed on (mo/day/yr) 11/3/08 and this record is true to the best of my knowledge and belief. Kansas Water Well Contractor's License No. 554 This Water Well Record was completed on (mo/day/yr) 11/4/08 under the business name of Muldrot Bluestem Environmental Engineering, Inc.
 by (signature) _____

INSTRUCTIONS: Please fill in blanks and circle the correct answers. Send three copies to Kansas Department of Health and Environment, Bureau of Water, 1000 S W Jackson St., Ste. 420, Topeka, Kansas 66620-0001. Telephone: 785-298-3585. Send one to Water Well Owner and retain one for your records.