

1	LOCATION OF WATER WELL: County: Stafford	Fraction NE ¼ NE ¼ NE ¼	Section Number 8	Township Number T 24 S	Range Number R 12W E/W
---	--	--	----------------------------	----------------------------------	----------------------------------

Distance and direction from nearest town or city street address of well if located within city?


3 W, 3/4 N of Stafford, Kansas

2] WATER WELL OWNER:	Allen Drilling Company	
RR#, St. Address, Box # :	1926 Main	Board of Agriculture, Division of Water Resources
City, State, ZIP Code :	Great Bend, Kansas 67530	Application Number: Unknown

3	LOCATE WELL'S LOCATION WITH AN "X" IN SECTION BOX:	4	DEPTH OF COMPLETED WELL: 80	ft.	ELEVATION: Unknown
---	--	---	-----------------------------	-----	--------------------

Depth(s) Groundwater Encountered 1. 36 ft. 2. 36 ft. 3. 36 ft.

WELL'S STATIC WATER LEVEL 36 ft. below land surface measured on mo/day/yr 8/10/81

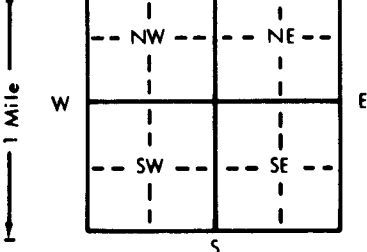

Pump test data: Well water was ft. after hours pumping gpm
 Est. Yield ... 60 ... gpm: Well water was ft. after hours pumping gpm
 Bore Hole Diameter ... 8 ... in. to ... 80 ... ft., and ... in. to ft.
 WELL WATER TO BE USED AS: 5 Public water supply 8 Air conditioning 11 Injection well
 1 Domestic 3 Feedlot 6 Oil field water supply 9 Dewatering 12 Other (Specify below)
 2 Irrigation 4 Industrial 7 Lawn and garden only 10 Observation well
 Was a chemical/bacteriological sample submitted to Department? Yes No; If yes, mo/day/yr sample was sub-
 mitted Water Well Disinfected? Yes No

5 TYPE OF BLANK CASING USED:		5 Wrought iron	8 Concrete tile	CASING JOINTS: <u>Glued</u> Clamped	
1 Steel	3 RMP (SR)	6 Asbestos-Cement	9 Other (specify below)	Welded	
2 <u>PVC</u>	4 ABS	7 Fiberglass		Threaded.	
Blank casing diameter 5 in. to 60 ft. Dia in. to ft. Dia in. to ft.					
Casing height above land surface 12 in. weight 2.8 lbs./ft. Wall thickness or gauge No. Sch. 40					

TYPE OF SCREEN OR PERFORATION MATERIAL:			7 <u>PVC</u>	10 Asbestos-cement
1 Steel	3 Stainless steel	5 Fiberglass	8 RMP (SR)	11 Other (specify)
2 Brass	4 Galvanized steel	6 Concrete tile	9 ABS	12 None used (open hole)

SCREEN OR PERFORATION OPENINGS ARE:

1 Continuous slot	3 Mill slot	5 Gauzed wrapped	8 Saw cut	11 None (open hole)
2 Louvered shutter	4 Key punched	6 Wire wrapped	9 <u>Drilled holes</u>	
		7 Torch cut	10 Other (specify)	

SCREEN-PERFORATED INTERVALS:		From 60 ft. to 80 ft.,		From ft. to ft.	
		From ft. to ft.,		From ft. to ft.	
GRAVEL PACK INTERVALS:		From 10 ft. to 80 ft.,		From ft. to ft.	
		From ft. to ft.,		From ft. to ft.	

6 GROUT MATERIAL: 1 Neat cement 2 Cement grout 3 Bentonite 4 Other

Grout Intervals: From 0 ft. to 10 ft. From ft. to ft. From ft. to ft. From ft. to ft.

What is the nearest source of possible contamination:

1 Septic tank	4 Lateral lines	7 Pit privy	10 Livestock pens	14 Abandoned water well
2 Sewer lines	5 Cess pool	8 Sewage lagoon	11 Fuel storage	15 <u>Oil well/Gas well</u>
3 Watertight sewer lines	6 Seepage pit	9 Feedyard	12 Fertilizer storage	16 Other (specify below)

Direction from well? **South**

How many feet? **60**

Direction from well?

[illegible]

7 CONTRACTOR'S OR LANDOWNER'S CERTIFICATION: This water well was (1) constructed, (2) reconstructed, or (3) plugged under my jurisdiction and was completed on (mo/day/year) 8/10/81 and this record is true to the best of my knowledge and belief. Kansas

Water Well Contractor's License No. 186 This Water Well Record was completed on (mo/day/yr) 9/15/81
under the business name of Kellys Water Wells by (signature) Kelly Price
INSTRUCTIONS: Use typewriter or ball point pen, PLEASE PRESS FIRMLY and PRINT clearly. Please fill in blanks, underline or circle the correct answers. Send top three copies to Kansas Department of Health and Environment, Division of Environment, Environmental Geology Section, Topeka, KS 66620. Send one to WATER WELL OWNER and retain one for your records.