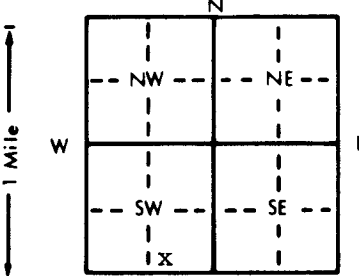


1 LOCATION OF WATER WELL:		Fraction	Section Number	Township Number	Range Number
County: Stafford		SW 1/4 SE 1/4 SW 1/4	11	T 24 S	R 12 E/W
Distance and direction from nearest town or city street address of well if located within city?					
Approximately 1/2 mile west and 1/2 mile north of Stafford					
2 WATER WELL OWNER:		City of Stafford			
RR#, St. Address, Box # :		Bill Kirkpatrick - City Superintendent			
City, State, ZIP Code :		P.O. Box 280 Stafford, KS 67578			
Board of Agriculture, Division of Water Resources		Application Number: SF 001			
3 LOCATE WELL'S LOCATION WITH AN "X" IN SECTION BOX:		4 DEPTH OF COMPLETED WELL: 146.5 ft. ELEVATION: unknown			
		Depth(s) Groundwater Encountered 1. ft. 2. ft. 3. ft.			
		WELL'S STATIC WATER LEVEL 26. ft. below land surface measured on mo/day/yr 8-3-92			
		Pump test data: Well water was not ch'd. ft. after hours pumping gpm			
		Est. Yield unknown gpm: Well water was ft. after hours pumping gpm			
		Bore Hole Diameter 36. in. to 146. ft., and in. to ft.			
		WELL WATER TO BE USED AS: 5 Public water supply 8 Air conditioning 11 Injection well			
		1 Domestic 3 Feedlot 6 Oil field water supply 9 Dewatering 12 Other (Specify below)			
		2 Irrigation 4 Industrial 7 Lawn and garden only 10 Monitoring well			
		Was a chemical/bacteriological sample submitted to Department? Yes. X. No.; If yes, mo/day/yr sample was submitted 6-3-92			
		Water Well Disinfected? Yes X No			
5 TYPE OF BLANK CASING USED:		CASING JOINTS: Glued Clamped			
1 Steel 3 RMP (SR)		Welded X			
2 PVC 4 ABS		Threaded			
Blank casing diameter 12 3/4 in. to 50.5 ft., Dia 12 3/4 in. to 131.5 ft., Dia 12 3/4 in. to 145.5 ft.					
Casing height above land surface 12 in., weight 49.56 lbs./ft. Wall thickness or gauge No. 375					
TYPE OF SCREEN OR PERFORATION MATERIAL:		7 PVC 10 Asbestos-cement			
1 Steel 3 Stainless steel 5 Fiberglass 8 RMP (SR) 11 Other (specify)					
2 Brass 4 Galvanized steel 6 Concrete tile 9 ABS 12 None used (open hole)					
SCREEN OR PERFORATION OPENINGS ARE:		5 Gauzed wrapped 8 Saw cut 11 None (open hole)			
1 Continuous slot 3 Mill slot 6 Wire wrapped 9 Drilled holes					
2 Louvered shutter 4 Key punched 7 Torch cut 10 Other (specify)					
SCREEN-PERFORATED INTERVALS: From 50.5 ft. to 58.5 ft., From ft. to ft.					
From 131.5 ft. to 143.5 ft., From ft. to ft.					
GRAVEL PACK INTERVALS: From 45 ft. to 65 ft., From ft. to ft.					
From 126 ft. to 146 ft., From ft. to ft.					
6 GROUT MATERIAL:		Bentonite Holeplug			
1 Neat cement 2 Cement grout 3 Bentonite 4 Other					
Grout Intervals: From 0-7 ft. to 7-30 ft., From 30-43 ft. to 65-124 ft., From 43-45 ft. to 124-126 ft.					
What is the nearest source of possible contamination:		10 Livestock pens 14 Abandoned water well			
1 Septic tank 4 Lateral lines 7 Pit privy 11 Fuel storage 15 Oil well/Gas well					
2 Sewer lines 5 Cess pool 8 Sewage lagoon 12 Fertilizer storage 16 Other (specify below)					
3 Watertight sewer lines 6 Seepage pit 9 Feedyard 13 Insecticide storage None known					
Direction from well?		How many feet?			
FROM	TO	LITHOLOGIC LOG	FROM	TO	PLUGGING INTERVALS
0	3	Topsoil	112	117	Sand and gravel, fine, mixed with clay
3	12	Clay, brown			
12	20	Clay, brown, caliche	117	129	Clay, reddish brown, very hard at 129'
20	25	Clay, gray and white			
25	27	Sand and gravel with clay, sandy	129	143	Sand and gravel, fine, some medium
27	32	Clay, white and gray	143	146	Clay, red, very hard
32	34	Sand and gravel, fine			
34	39	Clay, brown with sand streaks			
39	45	Sand and gravel, fine			
45	57	Sand and gravel, fine, medium			
57	77	Clay, streaks of sand			
77	84	Sand and gravel, fine mixed with clay			
84	112	Clay, reddish brown, streaks of sand			
7 CONTRACTOR'S OR LANDOWNER'S CERTIFICATION: This water well was (1) constructed, (2) reconstructed, or (3) plugged under my jurisdiction and was completed on (mo/day/year) 8-3-92 and this record is true to the best of my knowledge and belief. Kansas Water Well Contractor's License No. 185 This Water Well Record was completed on (mo/day/yr) 1-19-93 under the business name of Clarke Well & Equipment, Inc. by (signature) [Signature]					
INSTRUCTIONS: Use typewriter or ball point pen. PLEASE PRESS FIRMLY and PRINT clearly. Please fill in blanks, underline or circle the correct answers. Send top three copies to Kansas Department of Health and Environment, Bureau of Water, Topeka, Kansas 66620-0001. Telephone: 913-296-5545. Send one to WATER WELL OWNER and retain one for your records.					

OFFICE USE ONLY

T

R

E/W

SEC.

1/4

1/4

1/4