USE TYPEWRITER OR BALL POINT PEN-PRESS FIRMLY, PRINT CLEARLY.

WATER WELL RECORD
KSA 82a-1201-1215

Kansas Department of Health and Environment-Division of Environment
(Water well Contractors)
Topeka, Kansas 66620

1. Location of well:	County	Fraction	Section number	Township number	Range number
	Stafford	sw 1/4 se 1/4 sw 1/4	24	T 24 S	R 12w E/W

2. Distance and direction from nearest town or city:
Street address of well location if in city: 1s Stafford, Ks.

3. Owner of well: H-30 Drilling, Inc.
R.R. or street: 200 N. Main
City, state, zip code: Wichita, Ks. 67202

4. Locate with "X" in section below: Sketch map:

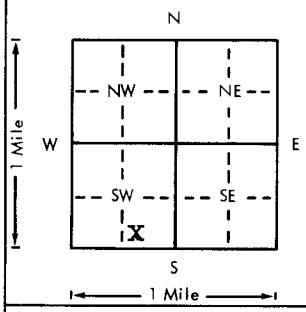

6. Bore hole dia. 7 in. Completion date
Well depth 75 ft. 8-8-77

7. __ Cable tool X Rotary __ Driven __ Dug
__ Hollow rod __ Jetted __ Bored __ Reverse rotary

8. Use: __ Domestic __ Public supply __ Industry
__ Irrigation __ Air conditioning __ Stock
__ Lawn X Oil field water __ Other

9. Casing: Material
Threaded __ Welded __
RMP __ PVC X
Dia. 4 in. to 75 ft. depth
Dia. __ in. to __ ft. depth
Height: Above ~~Below~~ Surface 12 in.
Weight __ lbs./ft.
Wall Thickness inches or gage No. Sch 40

5. Type and color of material	From	To
Top Soil Clay	0	30
Sandy Clay	30	50
Sand-Gravel	50	75

(Use a second sheet if needed)

10. Screen: Manufacturer's name Jetstream
Type pvc Dia. 4"
Slot/gauze 1/16 Length 20'
Set between 55 ft. and 75 ft.
ft. and ft.
Gravel pack? X Size range of material 1/8-3/4"

11. Static water level: mo./day/yr.
22 ft. below land surface Date 8-8-77

12. Pumping level below land surfaces:
ft. after hrs. pumping g.p.m.
ft. after hrs. pumping g.p.m.
Estimated maximum yield 50 g.p.m.

13. Water sample submitted: mo./day/yr.
__ Yes X No Date

14. Well head completion:
__ Pitless adapter 12 Inches above grade

15. Well grouted? X
With: __ Neat cement X Bentonite __ Concrete
Depth: From 0 ft. to 10 ft.

16. Nearest source of possible contamination: oil
ft. 60 Direction se Type test
Well disinfected upon completion? __ Yes X No

17. Pump: X Not installed
Manufacturer's name
Model number HP Volts
Length of drop pipe ft. capacity g.p.m.
Type:
__ Submersible __ Turbine
__ Jet __ Reciprocating
__ Centrifugal __ Other

T 24 R 12 E/W Sec 24 1/4 SE 1/4 SE 1/4 SE 1/4

18. Elevation:
Topography:
__ Hill
__ Slope
X Upland
__ Valley

19. Remarks:

20. Water well contractor's certification:
This well was drilled under my jurisdiction and this report is true to the best of my knowledge and belief.
Kelly's Waterwell Ser 186
Business name License No.
Address R2, Great Bend, Ks.
Signed Kelly Drise Date 7-11-79
Authorized representative

Forward the white, blue and pink copies to the Department of Health and Environment

Form WWC-5

MI-1023