(2)

WATER WELL RECORD Form WWC-5 KSA 82a-1212

1 LOCATION OF WATER WELL:	Fraction	Section Number	Township Number	Range Number
County: Stafford	NW ¼ NW ¼ NW ¼	4	T 24 S	R 13 E(W)

Distance and direction from nearest town or city street address of well if located within city? In town

2 WATER WELL OWNER: St. John Farmers Coop

RR#, St. Address, Box # : 312 West 1st.

City, State, ZIP Code : St. John, Ks.

Board of Agriculture, Division of Water Resources Application Number:

3 LOCATE WELL'S LOCATION WITH AN "X" IN SECTION BOX:

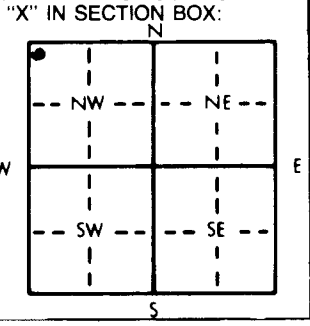

4 DEPTH OF COMPLETED WELL 20' ft. ELEVATION:

Depth(s) Groundwater Encountered 1. 16' ft. 2. ft. 3. ft.

WELL'S STATIC WATER LEVEL 16.50 ft. below land surface measured on mo/day/yr 6-30-97

Pump test data: Well water was ft. after hours pumping gpm

Est. Yield — gpm: Well water was ft. after hours pumping gpm

Bore Hole Diameter 3 1/2" in. to 20' ft., and in. to ft.

WELL WATER TO BE USED AS: 1 Domestic 2 Irrigation 3 Feedlot 4 Industrial 5 Public water supply 6 Oil field water supply 7 Lawn and garden only 8 Air conditioning 9 Dewatering 10 Monitoring well 11 Injection well (12) Other (Specify below) SVE well

Was a chemical/bacteriological sample submitted to Department? Yes (No); If yes, mo/day/yr sample was submitted

Water Well Disinfected? Yes (No)

5 TYPE OF BLANK CASING USED: 1 Steel [2 PVC] 3 RMP (SR) 4 ABS 5 Wrought iron 6 Asbestos-Cement 7 Fiberglass 8 Concrete tile 9 Other (specify below)

CASING JOINTS: Glued Clamped Welded Threaded X

Blank casing diameter 2.375 in. to 10' ft., Dia in. to ft., Dia in. to ft.

Casing height above land surface Flush Mt. in., weight lbs./ft. Wall thickness or gauge No. SDR-13 Sch 40

TYPE OF SCREEN OR PERFORATION MATERIAL: [7 PVC]

1 Steel 2 Brass 3 Stainless steel 4 Galvanized steel 5 Fiberglass 6 Concrete tile 8 RMP (SR) 9 ABS 10 Asbestos-cement 11 Other (specify) 12 None used (open hole)

SCREEN OR PERFORATION OPENINGS ARE:

1 Continuous slot [3 Mill slot] 2 Louvered shutter 4 Key punched 5 Gauzed wrapped 6 Wire wrapped 7 Torch cut 8 Saw cut 9 Drilled holes 10 Other (specify) 11 None (open hole)

SCREEN-PERFORATED INTERVALS: From 20' ft. to 10' ft., From ft. to ft.

From ft. to ft., From ft. to ft.

GRAVEL PACK INTERVALS: From 20' ft. to 8' ft., From ft. to ft.

From ft. to ft., From ft. to ft.

6 GROUT MATERIAL: 1 Neat cement (2) Cement grout (3) Bentonite 4 Other

Grout Intervals: From 8' ft. to 4' ft., From 4' ft. to 2½ ft., From ft. to ft.

What is the nearest source of possible contamination: (3) (2)

1 Septic tank 2 Sewer lines 3 Watertight sewer lines 4 Lateral lines 5 Cess pool 6 Seepage pit 7 Pit privy 8 Sewage lagoon 9 Feedyard 10 Livestock pens (11) Fuel storage 12 Fertilizer storage 13 Insecticide storage 14 Abandoned water well 15 Oil well/Gas well 16 Other (specify below)

Direction from well? West Southwest How many feet? 60'

FROM	TO	LITHOLOGIC LOG	FROM	TO	PLUGGING INTERVALS
0	1.0	Gravel road base			
1.0	3.75	Tan Gray silty sand, dry, no odor, fine grained sand			
3.75	6.0	Med Grayish Brn fine grained sand, well rounded & sorted, dry			
6.0	14.5	Med Brn to Gray Brn fine-coarse sand w/few pebbles, dry, no odor, well graded			
14.5	20.0	Gray fine-coarse grained sand & gravel wet at 16', strong odor, well graded.			
					F.M. to be installed by Remediation Contr.

7 CONTRACTOR'S OR LANDOWNER'S CERTIFICATION: This water well was [(1) constructed] (2) reconstructed, or (3) plugged under my jurisdiction and was completed on (mo/day/year) 6-30-97 and this record is true to the best of my knowledge and belief. Kansas Water Well Contractor's License No. 539 This Water Well Record was completed on (mo/day/yr) 7-15-97 under the business name of QB Environmental Drilling by (signature) James Baker

INSTRUCTIONS: Use typewriter or ball point pen. *PLEASE PRESS FIRMLY* and *PRINT* clearly. Please fill in blanks, underline or circle the correct answers. Send top three copies to Kansas Department of Health and Environment, Bureau of Water, Topeka, Kansas 66620-0001. Telephone: 913-296-5545. Send one to WATER WELL OWNER and retain one for your records.

OFFICE USE ONLY T R E/W SEC. ¼ ¼ ¼