

WATER WELL RECORD

Form WWC-5


Division of Water Resources: App. No.

1 LOCATION OF WATER WELL: Fraction NW SE NW Section Number 4 Township Number T 24 S F 13 W

Distance and direction from nearest town or city street address of well if located within city? 424 South Broadway, St. John Global Positioning System (decimal degrees, min. of 4 digits)

2 WATER WELL OWNER: City of St. John RR#, St. Address, Box #: PO Box 367 City, State, ZIP Code: St. John, KS. 67576

3 LOCATE WELL'S SECTION BOX: 4 DEPTH OF COMPLETED WELL 36 ft.

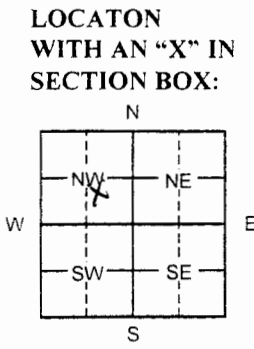

LOCATON WITH AN "X" IN SECTION BOX: Depth(s) Groundwater Encountered 1 AS9 ft. 2 ft. 3 ft. WELL'S STATIC WATER LEVEL 16.38 ft. below land surface measured on mo/day/yr 7/7/09

5 TYPE OF CASING USED: 1 Steel 3 RMP (SR) 6 Asbestos-Cement 9 Other (specify below) 2 PVC 4 ABS 7 Fiberglass 8 Concrete tile CASING JOINTS: Glued Clamped Welded Threaded X

Blank casing diameter 2 in. to 36 ft., Dia in. to ft., Dia in. to ft. Casing height below land surface 0.52 ft., Weight lbs./ft. Wall thickness or gauge No.

TYPE OF SCREEN OR PERFORATION MATERIAL: 1 Steel 3 Stainless steel 5 Fiberglass 7 PVC 9 ABS 11 Other (specify) 2 Brass 4 Galvanized steel 6 Concrete tile 8 RM (SR) 10 Asbestos-Cement 12 None used (open hole)

SCREEN OR PERFORATION OPENINGS ARE: 1 Continuous slot 3 Mill slot 5 Gauze wrapped 7 Torch cut 9 Drilled holes 11 None (open hole) 2 Louvered shutter 4 Key punched 6 Wire wrapped 8 Saw Cut 10 Other (specify)

6 GROUT MATERIAL: 1 Neat cement 2 Coated Bentonite 3 Med. Bentonite 4 Other Concrete: 0-1.5 ft.; Soil: 1.5-4 ft. Grout Intervals From 4 ft. to 16.75 ft. From 16.75 ft. to 29.8 ft. From ft. to ft.

What is the nearest source of possible contamination: 1 Septic tank 4 Lateral lines 7 Pit privy 10 Livestock pens 13 Insecticide Storage 16 Other (specify below) 2 Sewer lines 5 Cess pool 8 Sewage lagoon 11 Fuel storage 14 Abandoned water well 3 Watertight sewer lines 6 Seepage pit 9 Feedyard 12 Fertilizer storage 15 Oil well/ gas well

7 CONTRACTOR'S OR LANDOWNER'S CERTIFICATION: This water well was 1 constructed, (2) reconstructed, or (3) plugged under my jurisdiction and was completed on (mo/day/year) 6/2/09 and this record is true to the best of my knowledge and belief.

INSTRUCTIONS: Please fill in blanks or circle the correct answers. Send top three copies to Kansas Department of Health and Environment, Bureau of Water, Geology Section, 1000 SW Jackson St., Suite 420, Topeka, Kansas 66612-1367. Telephone 785-296-5522. Send one to WATER WELL OWNER and retain one for your records. Fee of \$5.00 for each constructed well. Visit us at http://www.kdheks.gov/waterwell.