


WATER WELL RECORD

Form WWC-5

Division of Water Resources: App. No.

1 LOCATION OF WATER WELL: Fraction Stafford NW SE NW Section Number 4 Township Number T 24 Range Number S 13 W

2 WATER WELL OWNER: City of St. John RR# St. Address. Box # PO Box 367 City, State, ZIP Code St. John, KS, 67576

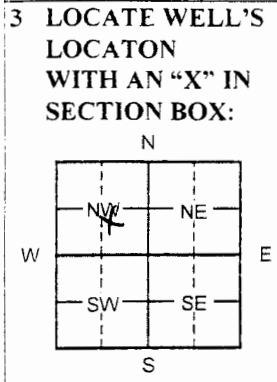

4 DEPTH OF COMPLETED WELL 36 ft. AS14 Depth(s) Groundwater Encountered 1 ft. 2 ft. 3 ft. WELL'S STATIC WATER LEVEL 16.71 ft. below land surface measured on mo/day/yr 7/7/09

5 TYPE OF CASING USED: 1 Steel 2 PVC 3 RMP (SR) 4 ABS 5 Wrought Iron 6 Asbestos-Cement 7 Fiberglass 8 Concrete tile 9 Other (specify below) CASING JOINTS: Glued Clamped Welded Threaded X

TYPE OF SCREEN OR PERFORATION MATERIAL: 1 Steel 2 Brass 3 Stainless steel 4 Galvanized steel 5 Fiberglass 6 Concrete tile 7 PVC 8 RM (SR) 9 ABS 10 Asbestos-Cement 11 Other (specify) 12 None used (open hole)

6 GROUT MATERIAL: 1 Neat cement 2 Coated Bentonite 3 Med. Bentonite 4 Other Concrete: 0-1.5 ft.; Soil: 1.5-4.5 ft. Grout Intervals From 4.5 ft. to 17.9 ft. From 17.9 ft. to 28.9 ft.

Table with 6 columns: FROM, TO, LITHOLOGIC LOG, FROM, TO, LITHOLOGIC LOG. Rows describe geological layers from 0 to 26 feet depth.

7 CONTRACTOR'S OR LANDOWNER'S CERTIFICATION: This water well was constructed. (2) reconstructed, or (3) plugged under my jurisdiction and was completed on (mo/day/year) 4/16/09 and this record is true to the best of my knowledge and belief.

INSTRUCTIONS: Please fill in blanks or circle the correct answers. Send top three copies to Kansas Department of Health and Environment, Bureau of Water.