


1	LOCATION OF WATER WELL: County: STAFFORD	Fraction NE 1/4 NW 1/4 NE 1/4	Section Number 11	Township Number T 24 S	Range Number R 13 E/W
---	---	----------------------------------	----------------------	---------------------------	--------------------------

Distance and direction from nearest town or city street address of well if located within city?

1/2 S 1 3/4 E. OF ST. JOHN. KS.

2	WATER WELL OWNER:	JOHN SWADER	
	RR#, St. Address, Box # :	1711 8th. AVE.	Board of Agriculture, Division of Water Resources
	City, State, ZIP Code :	DODGE CITY, KS. 67801	Application Number:

LOCATE WELL'S LOCATION WITH AN "X" IN SECTION BOX: 4 DEPTH OF COMPLETED WELL.....72..... ft. ELEVATION:

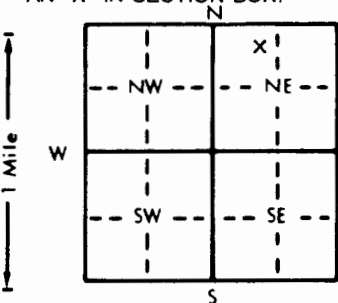

4 DEPTH OF COMPLETED WELL.....7.2..... ft. ELEVATION:.....
 Depth(s) Groundwater Encountered 1..... ft. 2..... ft. 3..... ft.
 WELL'S STATIC WATER LEVEL ..23..... ft. below land surface measured on mo/day/yr
 Pump test data: Well water was ft. after hours pumping gpm
 Est. Yield gpm: Well water was ft. after hours pumping gpm
 Bore Hole Diameter... 9 in. to ft., and in. to ft.
 WELL WATER TO BE USED AS: 5 Public water supply 8 Air conditioning 11 Injection well
 X Domestic 3 Feedlot 6 Oil field water supply 9 Dewatering 12 Other (Specify below)
 2 Irrigation 4 Industrial 7 Lawn and garden only 10 Monitoring well
 Was a chemical/bacteriological sample submitted to Department? Yes.....No...X.....; If yes, mo/day/yr sample was sub-
 mitted Water Well Disinfected? Yes X No

5	TYPE OF BLANK CASING USED:		5 Wrought iron	8 Concrete tile	CASING JOINTS: Glued . . . ☒ . . . Clamped . . . Welded . . . Threaded . . .
	1 Steel	3 RMP (SR)	6 Asbestos-Cement	9 Other (specify below)	
	2 PVC	4 ABS	7 Fiberglass		

Blank casing diameter 5 in. to 62 ft. Dia in. to ft. Dia in. to ft.
Casing height above land surface 24 in., weight lbs./ft. Wall thickness or gauge No.

TYPE OF SCREEN OR PERFORATION MATERIAL:			☒ PVC	10 Asbestos-cement
1 Steel	3 Stainless steel	5 Fiberglass	8 RMP (SR)	11 Other (specify)
2 Brass	4 Galvanized steel	6 Concrete tile	9 ABS	12 None used (open hole)

SCREEN OR PERFORATION OPENINGS ARE:		5 Gauzed wrapped	8 Saw cut	11 None (open hole)
1 Continuous slot	3 Mill slot	6 Wire wrapped	9 Drilled holes	
2 Louvered shutter	4 Key punched	7 Torch cut	10 Other (specify)	

SCREEN-PERFORATED INTERVALS:	From 62 ft. to 72 ft.,	From ft. to ft.
	From ft. to ft.,	From ft. to ft.
GRAVEL PACK INTERVALS:	From 23 ft. to 72 ft.,	From ft. to ft.
	From ft. to ft.,	From ft. to ft.

6 GROUT MATERIAL: 1 Neat cement 2 Cement grout ☒ Bentonite 4 Other
Grout Intervals: From 3 ft. to 23 ft. From ft. to ft. From ft. to ft.

What is the nearest source of possible contamination:

1 Septic tank	4 Lateral lines	7 Pit privy	10 Livestock pens	14 Abandoned water well
2 Sewer lines	5 Cess pool	8 Sewage lagoon	11 Fuel storage	15 Oil well/Gas well
3 Watertight sewer lines	6 Seepage pit	9 Feedyard	12 Fertilizer storage	16 Other (specify below)
			13 Insecticide storage	NONE

Direction from well? _____ How many feet? _____

[illegible]

7] CONTRACTOR'S OR LANDOWNER'S CERTIFICATION: This water well was (1) constructed, (2) reconstructed, or (3) plugged under my jurisdiction and was completed on (mo/day/year) 3-7-91 and this record is true to the best of my knowledge and belief. Kansas Water Well Contractor's License No. 462-B This Water Well Record was completed on (mo/day/yr) 3-28-91 under the business name of SAM'S WATER WELL SERVICE by (signature) [Signature]

INSTRUCTIONS: Use typewriter or ball point pen. PLEASE PRESS FIRMLY and PRINT clearly. Please fill in blanks, underline or circle the correct answers. Send top three copies to Kansas Department of Health and Environment, Bureau of Water, Topeka, Kansas 66620-7320. Telephone: 913-296-5545. Send one to WATER WELL OWNER and retain one for your records.