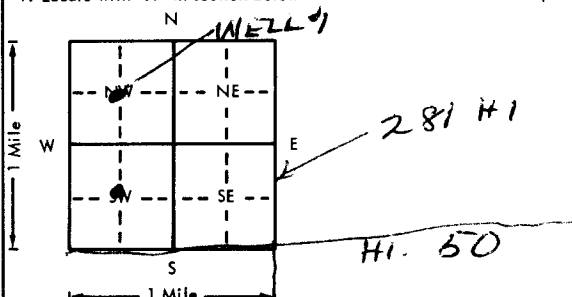


USE TYPEWRITER OR BALL POINT PEN-PRESS FIRMLY, PRINT CLEARLY.

WATER WELL RECORD
KSA 82a-1201-1215

Kansas Department of Health and Environment-Division of Environment
(Water well Contractors)
Topeka, Kansas 66620

1. Location of well:		County Stafford	Fraction SE 1/4 NW 1/4 NW 1/4	Section number 16	Township number T 24 S R 13 (EW)	Range number
2. Distance and direction from nearest town or city: 2 1/2 S. 1/2 KW Street address of well location if in city: ST. JOHN.				3. Owner of well: Kent Rixon R.R. or street: City, state, zip code: St. John, Kansas 67576		
4. Locate with "X" in section below: Sketch map: 				6. Bore hole dia. 28 in. Completion date _____ Well depth 90 ft. Oct. 2, 1975		
5. Type and color of material				From	To	7. <input type="checkbox"/> Cable tool <input type="checkbox"/> Rotary <input type="checkbox"/> Driven <input type="checkbox"/> Dug <input type="checkbox"/> Hollow rod <input type="checkbox"/> Jetted <input type="checkbox"/> Bored <input checked="" type="checkbox"/> Reverse rotary
						8. Use: <input type="checkbox"/> Domestic <input type="checkbox"/> Public supply <input type="checkbox"/> Industry <input checked="" type="checkbox"/> Irrigation <input type="checkbox"/> Air conditioning <input type="checkbox"/> Stock <input type="checkbox"/> Lawn <input type="checkbox"/> Oil field water <input type="checkbox"/> Other
						9. Casing: Material Steel Height: Above or below Threaded <input type="checkbox"/> Welded <input checked="" type="checkbox"/> Surface 8 in. RMP <input type="checkbox"/> PVC <input type="checkbox"/> Weight 30 lbs./ft. Dia. 16 in. to 50 ft. depth Wall Thickness: inches or Dia. _____ in. to _____ ft. depth gage No. 3116
						10. Screen: Manufacturer's name _____ Donre Type Laver Dia. 16 Slot/gauze 3/16 Length 40 Set between 50 ft. and 90 ft. _____ ft. and _____ ft. Gravel pack <input checked="" type="checkbox"/> Size range of material 1/8 - 1/4
						11. Static water level: _____ mo./day/yr. 11 ft. below land surface Date Aug. 5, 75
						12. Pumping level below land surfaces: 39 ft. after 1 hrs. pumping 1200 g.p.m. 34 ft. after 1/2 hrs. pumping 1000 g.p.m. Estimated maximum yield 1400 g.p.m.
						13. Water sample submitted: _____ mo./day/yr. Yes <input checked="" type="checkbox"/> No <input type="checkbox"/> Date OCT. 1975
						14. Well head completion: <input type="checkbox"/> Pitless adapter _____ Inches above grade
						15. Well grouted? <input checked="" type="checkbox"/> yes With: <input type="checkbox"/> Neat cement <input checked="" type="checkbox"/> Bentonite <input checked="" type="checkbox"/> Concrete Depth: From 0 ft. to 10 ft.
						16. Nearest source of possible contamination: ft. _____ Direction _____ Type _____ Well disinfected upon completion? Yes <input type="checkbox"/> No <input checked="" type="checkbox"/>
						17. Pump: _____ Not installed Manufacturer's name Western Sandwell Model number 3-12H HP 60 Volts _____ Length of drop pipe 60 ft. capacity 1600 g.p.m. Type: <input type="checkbox"/> Submersible <input checked="" type="checkbox"/> Turbine <input type="checkbox"/> Jet <input type="checkbox"/> Reciprocating <input type="checkbox"/> Centrifugal <input type="checkbox"/> Other
(Use a second sheet if needed)						
18. Elevation:		19. Remarks:		20. Water well contractor's certification: This well was drilled under my jurisdiction and this report is true to the best of my knowledge and belief. Darling Drilling Co. 189 Business name License No. Address 11 W. 4th, Hutchinson, Ks. Signed Donald Dushy Date 6/14/75 Authorized representative		
Topography: <input type="checkbox"/> Hill <input type="checkbox"/> Slope <input checked="" type="checkbox"/> Upland <input type="checkbox"/> Valley						

27 130 16 SE NW 1/4 1/4 9/4

Forward the white, blue and pink copies to the Department of Health and Environment

Form WWC-5