USE TYPEWRITER OR BALL POINT PEN-PRESS FIRMLY, PRINT CLEARLY.

T R EW sec 1/4 1/4 1/4 No.

WATER WELL RECORD
KSA 82a-1201-1215

Kansas State Dept. Of Health
(Water Well Contractors)
Forbes-Bldg. 740
Topeka, Kansas 66620

1 Location of well:	County	Township name	Fraction	Section number	Town number	Range number
	Stafford		NW¼	19	T24S	R13W

Distance and direction from nearest town or city: 6 mi SW of St. John

Street address of well location if in city:

3 Owner of well: Walls Bros.

Address: St. John, Kansas 67576

Locate with "X" in section below:

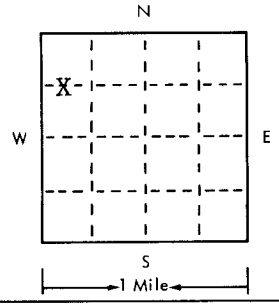

Sketch map:

4 Well depth: 50 ft. Date of completion 7-18-75
Well diameter 9 in.

5 ☐ Cable tool ☒ Rotory ☐ Driven ☐ Dug
☐ Hollow rod ☐ Jetted ☐ Bored ☐ Reverse rotary

6 Use: ☒ Domestic ☐ Public supply ☐ Industry
☐ Irrigation ☐ Air conditioning ☐ Commercial
☐ Test well ☐ _____

7 Casing: Material Styrene Weight: (above) below
Threaded ☐ Welded ☐ Surface 12 in.
Diam. 5 in. to 40 ft. depth Weight 1.5 lbs./ft.
___ in. to ___ ft. depth Drive shoe? ☐ Yes ☒ No

2 Type and color of material	From	To
Top Soil & brown clay	0	6
Sand & Gravel	6	50
(use a secand sheet if needed)		

8 Screen: Styrene
Manufacturer Jess & Lowell-200
Type Styrene Dia. 5"
Slot gauze 1/8 Length 40' 12'
Set between 40 ft. and 50 ft.
Fittings:
Gravel pack ☒ Yes ☐ No Size range of material 3/8-200

9 Static water level:
18 ft. below land surface Date 7-18-75

10 Pumping level below land surfaces: N/C
___ ft. after ___ hrs. pumping ___ g.p.m.
___ ft. after ___ hrs. pumping ___ g.p.m.
Estimated maximum yield ___ g.p.m.

11 Water sample submitted:
☐ Yes ☒ No Date ___

12 Well head completion:
☐ Pitless adapter ☐ 12 inches above grade

13 Well grouted? ☒ Yes ☐ No
☐ Neat cement ☐ Bentonite ☐ _____
Depth: From 0 ft. to 10 ft.

14 Nearest source of possible contamination: None Known
ft. ___ Direction ___ Type ___
Well disinfected upon completion? ☒ Yes ☐ No

15 Pump: ☒ Not installed
Manufacturer's name ___
Model number ___ HP ___ Volts ___
Length of drop pipe ___ ft. capacity ___ g.m.p.
Type:
☐ Submersible ☐ Turbine
☐ Jet ☐ Reciprocoting
☐ Certrifugal ☐ Other

16 Remorks: elevation

Topography:
☐ Hill
☐ Slope
☐ Upland
☐ Valley

17 Water well contractor's certification:
This well was drilled under my jurisdiction and this report is true to the best of my knowledge and belief.
Clarke Well & Eq., Inc. 185
Business name License No.
Address Great Bend, Kansas
Signed _____ Date 7-18-75
Authorized representative

Forward the white, blue and pink copies to the Kansas Stote Dept. Of Heolth.

Form WWC-5

677-H