

1 LOCATION OF WATER WELL: County: STAFFORD	Fraction W/2 1/4 W/2 1/4 NW 1/4	Section Number @ 21	Township Number T 24 S	Range Number R 13 E/W
---	---	------------------------	---------------------------	--------------------------


Distance and direction from nearest town or city street address of well if located within city?

2 1/2 S OF ST. JOHN, KS.

2 WATER WELL OWNER: WOODMAN- IANNITTI OIL CO.
RR#, St. Address, Box # : BOX 308
City, State, ZIP Code : GREAT BEND, KS. 67530

Board of Agriculture, Division of Water Resources
Application Number: T91-0401

3 LOCATE WELL'S LOCATION WITH AN "X" IN SECTION BOX: 4 DEPTH OF COMPLETED WELL.....69..... ft. ELEVATION:
 Depth(s) Groundwater Encountered 1 ft 2 ft 3 ft

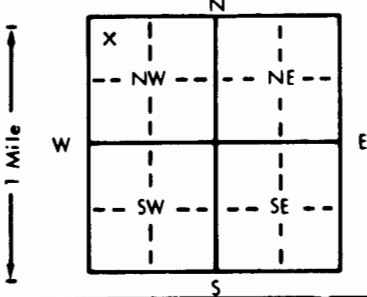

4 DEPTH OF COMPLETED WELL.....69..... ft. ELEVATION:.....

Depth(s) Groundwater Encountered 1..... ft. 2..... ft. 3..... ft.

WELL'S STATIC WATER LEVEL.....26..... ft. below land surface measured on mo/day/yr.....

Pump test data: Well water was..... ft. after..... hours pumping..... gpm

Est. Yield..... gpm: Well water was..... ft. after..... hours pumping..... gpm

Bore Hole Diameter.....9..... in. to..... ft., and..... in. to..... ft.

WELL WATER TO BE USED AS:

1 Domestic	3 Feedlot	5 Public water supply	8 Air conditioning	11 Injection well
2 Irrigation	4 Industrial	6 Oil field water supply	9 Dewatering	12 Other (Specify below)
		7 Lawn and garden only	10 Monitoring well	

Was a chemical/bacteriological sample submitted to Department? Yes.....No.....☒.....; If yes, mo/day/yr sample was submitted.....

Water Well Disinfected? Yes.....No.....☒.....


Blank casing diameter 5 in. to 59 ft., Dia. Casing height above land surface 12 in., weight _____ lbs./ft. Wall thickness or gauge No. _____

TYPE OF SCREEN OR PERFORATION MATERIAL: 1 Steel 2 Brass 3 Stainless steel 4 Galvanized steel 5 Fiberglass 6 Concrete tile 7 Gauzed wrapped 8 Wire wrapped 9 Torch cut 10 Other (specify) _____

SCREEN OR PERFORATION OPENINGS ARE: 1 Continuous slot 2 Mill slot 3 Louvered shutter 4 Key punched 5 Gauzed wrapped 6 Wire wrapped 7 Torch cut 8 Saw cut 9 Drilled holes 10 Other (specify) _____

SCREEN-PERFORATED INTERVALS: From 59 ft. to 69 ft. From _____ ft. to _____ ft. From _____ ft. to _____ ft.

GRAVEL PACK INTERVALS: From 20 ft. to 69 ft. From _____ ft. to _____ ft. From _____ ft. to _____ ft.

6 GROUT MATERIAL: 1 Neat cement 2 Cement grout ~~3 Bentonite~~ 4 Other
Grout Intervals: From ... 0 ... ft. to ... 20 ... ft., From ... ft. to ... ft., From ... ft. to ... ft.
What is the nearest source of possible contamination:
1 Septic tank 4 Lateral lines 7 Pit privy 10 Livestock pens 14 Abandoned water well
2 Sewer lines 5 Cess pool 8 Sewage lagoon 11 Fuel storage 15 Oil well/Gas well
3 Watertight sewer lines 6 Seepage pit 9 Feedyard 12 Fertilizer storage 16 Other (specify below)
13 Insecticide storage NONE
Direction from well? How many feet?

[illegible]

7 CONTRACTOR'S OR LANDOWNER'S CERTIFICATION: This water well was (x) constructed, (2) reconstructed, or (3) plugged under my jurisdiction and was completed on (mo/day/year) 9-7-91 and this record is true to the best of my knowledge and belief. Kansas Water Well Contractor's License No. 462-B This Water Well Record was completed on (mo/day/yr) 10-1-91 under the business name of SAM'S WATER WELL SERVICE by (signature) Lara C. [Signature]