USE TYPEWRITER OR BALL POINT PEN-PRESS FIRMLY, PRINT CLEARLY.

WATER WELL RECORD
KSA 82a-1201-1215

Kansas Department of Health and Environment-Division of Environment
(Water well Contractors)
Topeka, Kansas 66620

1. Location of well:	County	Fraction	Section number	Township number	Range number
	Stafford	CW½ 1/4 1/4 SE 1/4	25	T 24 S	R 13W E/W

2. Distance and direction from neorest town or city: 4½s 2 3/4e
Street address of well location if in city: St John, Ks.

3. Owner of well: Dnb Drlg inc.
R.R. or street: 515 Garvey Bldg
City, state, zip code: Wichita, Ks. 67202

4. Locate with "X" in section below: Sketch map:

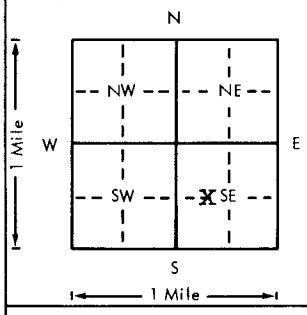

6. Bore hole dia. 8 in. Completion date
Well depth 60 ft. 5-31-78

7. __ Cable tool X Rotary __ Driven __ Dug
__ Hollow rod __ Jetted __ Bored __ Reverse rotary

8. Use: __ Domestic __ Public supply __ Industry
__ Irrigation __ Air conditioning __ Stock
__ Lawn X Oil field water __ Other

9. Casing: Material ____ Height: Above or ~~Below~~
Threaded ____ Welded ____ Surface 12 in.
RMP ____ PVC X Weight 2.8 lbs./ft.
Dia. 5 in. to 60 ft. depth Wall Thickness: inches or
Dia. ____ in. to ____ ft. depth gage No. Sch 40

5. Type and color of material	From	To
Top Soil-Clay	0	30
Sand	30	40
Sand-Gravel	40	60
(Use a second sheet if needed)		

10. Screen: Manufacturer's name Jetstream
Type pvc Dia. 5"
Slot/gouze 1/32" Length 20'
Set between 40 ft. and 60 ft.
ft. and ft.
Gravel pack? X Size range of material 1/8-3/4"

11. Static water level: mo./day/yr.
18 ft. below land surface Dote 5-31-78

12. Pumping level below land surfaces:
____ ft. after ____ hrs. pumping ____ g.p.m.
____ ft. after ____ hrs. pumping ____ g.p.m.
Estimated maximum yield 60 g.p.m.

13. Water somple submitted: mo./day/yr.
__ Yes X No Date

14. Well heod completion:
__ Pitless adapter 12 Inches above grade

15. Well grouted? X
With: __ Neat cement X Bentonite __ Concrete
Depth: From 0 ft. to 10 ft.

16. Negrest source of possible contamination: oil
ft. 70 Direction se Type test
Well disinfected upon completion? __ Yes X No

17. Pump: X Not installed
Manufacturer's name
Model number HP Volts
Length of drop pipe ft. capacity g.p.m.
Type:
__ Submersible __ Turbine
__ Jet __ Reciprocating
__ Centrifugal __ Other

18. Elevation:
Topography:
__ Hill
__ Slope
X Upland
__ Valley

19. Remarks:

20. Water well contractor's certification:
This well was drilled under my jurisdiction and this report is true to the best of my knowledge and belief.
Business name Kellys Waterwell Ser License No. 186
Address R2 Great Bend, Ks.
Signed Kelly Price Date 10-9-78
Authorized representative

Forward the white, blue and pink copies to the Department of Health and Environment

Form WWC-5

M1-1023

24 T 13 R W 25 Sec CW½ 1/4 1/4 SE 1/4