

WATER WELL PLUGGING RECORD Form WWC-5P

KSA 82a-1212

ID NO.


1 LOCATION OF WATER WELL: Fraction NW 1/4 NW 1/4 NE 1/4 Section Number 21 Township Number 24 Range Number 14 EW
 County: STAFFORD

Distance and direction from nearest town or city street address of well if located within city?

0 5 1/2 miles East of Macksville

2 WATER WELL OWNER: KERRY SUITER Global Positioning Systems (decimal degrees, min. of 4 digits)
 RR#, St. Address, Box #: 25 S.W. 60th AVE. Latitude: _____
 City, State ZIP Code: ST. JOHN, KANSAS 67576 Longitude: _____
 Elevation: _____
 Datum: _____
 Data Collection Method: _____

3 MARK WELL'S LOCATION WITH AN "X" IN SECTION BOX:

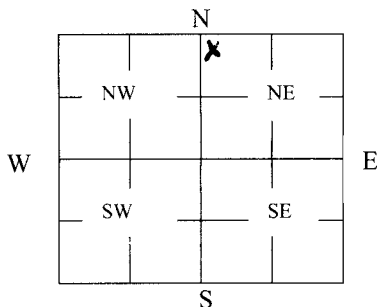

4 DEPTH OF WELL 108 ft.

WELL'S STATIC WATER LEVEL 27 ft

WELL WAS USED AS:

- 1 Domestic
2 Irrigation
 3 Feedlot
 4 Industrial

- 5 Public Water Supply
 6 Oil Field Water Supply
 7 Domestic (Lawn & Garden)
 8 Air Conditioning

- 9 Dewatering
 10 Monitoring
 11 Injection Well
 12 Other _____

Was a chemical/bacteriological sample submitted to Department? Yes _____ No X

5 TYPE OF BLANK CASING USED:

- 1 Steel 3 RMP (SR) 5 Wrought 7 Fiberglass 9 Other (Specify below)
 2 PVC 4 ABS 6 Asbestos-Cement 8 Concrete Tile

Blank casing diameter 16 in. Was casing pulled? Yes _____ No X If yes, how much _____
 Casing height ~~above~~ or below land surface 48" in.

6 GROUT PLUG MATERIAL: 1 Neat cement 2 Cement grout 3 Bentonite 4 Other _____

Grout Plug Intervals: From 27 ft. to 26 ft., From 26 ft. to 4 ft., From _____ to _____ ft.

BentoniteCement

What is the nearest source of possible contamination:

- 1 Septic tank 6 Seepage pit 11 Fuel Storage 16 Other (specify below)
 2 Sewer lines 7 Pit privy 12 Fertilizer storage none in field
 3 Watertight sewer lines 8 Sewage lagoon 13 Insecticide storage
 4 Lateral lines 9 Feedyard 14 Abandoned water well Direction from well? _____
 5 Cess pool 10 Livestock pens 15 Oil well/Gas well How many feet? _____

well was chlorinated

FROM	TO	PLUGGING MATERIALS	FROM	TO	PLUGGING MATERIALS
108'	27'	sand & gravel			
27'	26'	bentonite			
26'	4'	cement			
casing cut off 4' below ground level					
Richard Harper of KDHE. was contacted at 8:39 AM for plugging procedure.					

7 CONTRACTOR'S OR LANDOWNER'S CERTIFICATION: This water well was plugged under my jurisdiction and was completed on (mo/day/year) 5-18-09 and this record is true to the best of my knowledge and belief. Kansas Water Well Contractor's License No. 186. This Water Well Record was completed on (mo/day/year) 5/18/09 under the business name of Kellys Water Well by (signature) [Signature]

INSTRUCTIONS: Use typewriter or ballpoint pen. Please press firmly and print clearly. Please fill in blanks, underline or circle the correct answers. Send top three copies to Kansas Department of Health and Environment, Bureau of Water, Geology Section, 1000 SW Jackson St., Ste. 420, Topeka, Kansas 66612-1367. Telephone: 785/296-5522. Send one to Water Well Owner and retain one for your records. Visit us at <http://www.kdheks.gov/geo/waterwells>.