USE TYPEWRITER OR BALL POINT PEN-PRESS FIRMLY, PRINT CLEARLY.

WATER WELL RECORD
KSA 82a-1201-1215

Kansas Department of Health and Environment-Division of Environment
(Water well Contractors)
Topeka, Kansas 66620

Switze #2

| 1. Location of well: | County | Fraction | Section number | Township number | Range number |
|---|---|---|---|---|---|
| | Stafford | SE 1/4 NW 1/4 NW 1/4 | 10 | T 24S S | R 14W E/W |

2. Distance and direction from nearest town or city: Dilwyn Rd Hwy 50 2 miles North
Street address of well location if in city: 1 mile East 1/4 mile South

3. Owner of well: Huskey Dalp
R.R. or street:
City, state, zip code: Great Bend, Ks

4. Locate with "X" in section below:

Sketch map:

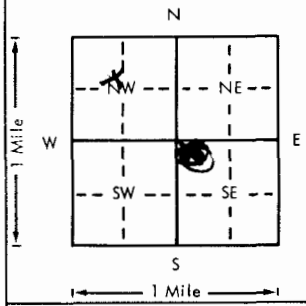


6. Bore hole dia. ___ in. Completion date ___
Well depth 75 ft. 10-21-78

7. __ Cable tool X Rotary __ Driven __ Dug
__ Hollow rod __ Jetted __ Bored __ Reverse rotary

8. Use: __ Domestic __ Public __ Industry
__ Irrigation __ Air conditioning __ Stock
__ Lawn X Oil field water __ Other

9. Casing: Material ___ Height: Above or below
Threaded ___ Welded X Surface 12 in.
RMP ___ PVC X Weight 278-3 lbs./ft.
Dia. 5 in. to 75 ft. depth Wall Thickness: inches or
Dia. ___ in. to ___ ft. depth gage No. 200

10. Screen: Manufacturer's name Peerless
Type Saw Dia. 5
Slot/gauze 42 Length 20
Set between 75 ft. and 55 ft.
___ ft. and ___ ft.
Gravel pack yes Size range of material 1/8-3/4

11. Static water level: mo./day/yr.
33 ft. below land surface Date 10-21-78

12. Pumping level below land surfaces:
___ ft. after ___ hrs. pumping ___ g.p.m.
___ ft. after ___ hrs. pumping ___ g.p.m.
Estimated maximum yield ___ g.p.m.

13. Water sample submitted: mo./day/yr.
__ Yes X No Date ___

14. Well head completion:
__ Pitless adapter ___ Inches above grade

15. Well grouted? yes
With: __ Neat cement X Bentonite __ Concrete
Depth: From 0 ft. to 10 ft.

16. Nearest source of possible contamination:
ft. ___ Direction ___ Type ___
Well disinfected upon completion? ___ Yes ___ No

17. Pump: X Not installed
Manufacturer's name ___
Model number ___ HP ___ Volts ___
Length of drop pipe ___ ft. capacity ___ g.p.m.
Type:
__ Submersible __ Turbine
__ Jet __ Reciprocating
__ Centrifugal __ Other

| 5. Type and color of material | From | To |
|---|---|---|
| Sandy Clay | 0 | 30 |
| Clay | 30 | 50 |
| Gravel | 50 | 75 |

(Use a second sheet if needed)

18. Elevation:

Topography:
__ Hill
X Slope
__ Upland
__ Valley

19. Remarks:

20. Water well contractor's certification:
This well was drilled under my jurisdiction and this report is true to the best of my knowledge and belief.
Business name Myers Water Well License No. 143
Address Great Bend Ks
Signature Floyd Rosendale Date 10-21
Authorized representative

T 24 R 14 E/W Sec 10 1/4 SE 1/4 NW 1/4 NW

Forward the white, blue and pink copies to the Department of Health and Environment

Form WWC-5

MI-1023