


D00F#1

1 LOCATION OF WATER WELL: County: <u>STAFFORD</u> Distance and direction from nearest town or city street address of well if located within city? <u>ST JOHN 2 1/2 S 2 1/2 W NORTHSIDE</u>	Fraction <u>SW 1/4 SW 1/4 SE 1/4</u>	Section Number <u>13</u>	Township Number T <u>24</u> S	Range Number R <u>14</u> EW
---	---	-----------------------------	----------------------------------	--------------------------------

2 WATER WELL OWNER: R.D. DRILLING CO.
RR#, St. Address, Box #: BOX 183B INC.
City, State, ZIP Code: GREAT BEND, KS 67530
Board of Agriculture, Division of Water Resources
Application Number: T82-438

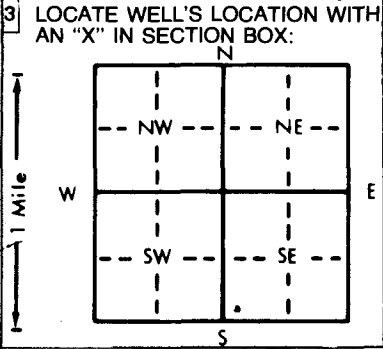

4 DEPTH OF COMPLETED WELL: 45 ft. ELEVATION: _____
Depth(s) Groundwater Encountered 1. 24 ft. 2. _____ ft. 3. _____ ft.
WELL'S STATIC WATER LEVEL 8 ft. below land surface measured on mo/day/yr 8-16-82
Pump test data: Well water was _____ ft. after _____ hours pumping _____ gpm
Est. Yield _____ gpm: Well water was _____ ft. after _____ hours pumping _____ gpm
Bore Hole Diameter: 7.718 in. to 4.5 in. and _____ in. to _____ in. ft.
WELL WATER TO BE USED AS: 5 Public water supply 8 Air conditioning 11 Injection well
1 Domestic 3 Feedlot 6 Oil field water supply 9 Dewatering 12 Other (Specify below)
2 Irrigation 4 Industrial 7 Lawn and garden only 10 Observation well
Was a chemical/bacteriological sample submitted to Department? Yes _____ No _____; If yes, mo/day/yr sample was submitted
Water Well Disinfected? Yes _____ No _____

5 TYPE OF BLANK CASING USED: 5 Wrought iron 8 Concrete tile CASING JOINTS: Glued X Clamped _____
1 Steel 3 RMP (SR) 6 Asbestos-Cement 9 Other (specify below) Welded _____
2 PVC 4 ABS 7 Fiberglass _____ Threaded _____
Blank casing diameter 5 in. to 2.5 ft. Dia. _____ in. to _____ ft. Dia. _____ in. to _____ ft.
Casing height above land surface 12 in., weight 2.65 lbs./ft. Wall thickness or gauge No. 214
TYPE OF SCREEN OR PERFORATION MATERIAL: 7 PVC 10 Asbestos-cement
1 Steel 3 Stainless steel 5 Fiberglass 8 RMP (SR) 11 Other (specify) _____
2 Brass 4 Galvanized steel 6 Concrete tile 9 ABS 12 None used (open hole)
SCREEN OR PERFORATION OPENINGS ARE: 1/8 5 Gauzed wrapped 8 Saw cut 11 None (open hole)
1 Continuous slot 3 Mill slot 6 Wire wrapped 9 Drilled holes
2 Louvered shutter 4 Key punched 7 Torch cut 10 Other (specify) _____
SCREEN-PERFORATED INTERVALS: From 25 ft. to 45 ft. From _____ ft. to _____ ft.
From _____ ft. to _____ ft. From _____ ft. to _____ ft.
GRAVEL PACK INTERVALS: From 15 ft. to 45 ft. From _____ ft. to _____ ft.
From _____ ft. to _____ ft. From _____ ft. to _____ ft.

6 GROUT MATERIAL: 1 Neat cement 2 Cement grout 3 Bentonite 4 Other _____
Grout Intervals: From 0 ft. to 10 ft., From _____ ft. to _____ ft., From _____ ft. to _____ ft.
What is the nearest source of possible contamination: NONE 10 Livestock pens 14 Abandoned water well
1 Septic tank 4 Lateral lines 7 Pit privy 11 Fuel storage 15 Oil well/Gas well
2 Sewer lines 5 Cess pool 8 Sewage lagoon 12 Fertilizer storage 16 Other (specify below)
3 Watertight sewer lines 6 Seepage pit 9 Feedyard 13 Insecticide storage
Direction from well? _____ How many feet? _____

FROM	TO	LITHOLOGIC LOG	FROM	TO	LITHOLOGIC LOG
<u>0</u>	<u>5</u>	<u>SOIL</u>			
<u>5</u>	<u>13</u>	<u>SANDY CLAY</u>			
<u>13</u>	<u>20</u>	<u>SAND</u>			
<u>20</u>	<u>45</u>	<u>GRAVEL</u>			

7 CONTRACTOR'S OR LANDOWNER'S CERTIFICATION: This water well was (1) constructed, (2) reconstructed, or (3) plugged under my jurisdiction and was completed on (mo/day/year) 8-16-82 and this record is true to the best of my knowledge and belief. Kansas Water Well Contractor's License No. 389. This Water Well Record was completed on (mo/day/yr) 8-2-82 under the business name of REISER WATER WELL SERV. by (signature) Richard Reiser
INSTRUCTIONS: Use typewriter or ball point pen, PLEASE PRESS FIRMLY and PRINT clearly. Please fill in blanks, underline or circle the correct answers. Send top three copies to Kansas Department of Health and Environment, Division of Environment, Environmental Geology Section, Topeka, KS 66620. Send one to WATER WELL OWNER and retain one for your records.

OFFICE USE ONLY
T
R
14
EW
SEC.
13
SW 1/4
SW 1/4
SE 1/4