USE TYPEWRITER OR BALL POINT PEN-PRESS FIRMLY, PRINT CLEARLY.

WATER WELL RECORD
KSA 82a-1201-1215

Kansas Department of Health and Environment-Division of Environment
(Water well Contractors)
Topeka, Kansas 66620

Meyer #1

1. Location of well: County: Stafford | Fraction: C N½ SE 1/4 1/4 1/4 | Section number: 25 | Township number: T 24 S | Range number: R 14 W E/W

2. Distance and direction from nearest town or city: 5 South
Street address of well location if in city: 3½ West St John

3. Owner of well: H. 30 Drilling Inc
R.R. or street:
City, state, zip code: Wichita Kansas

4. Locate with "X" in section below: Sketch map:

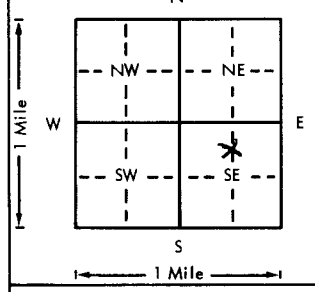

6. Bore hole dia. 8 in. Completion date
Well depth 60 ft. 1-9-78

7. __ Coble tool X Rotary __ Driven __ Dug
__ Hollow rod __ Jetted __ Bored __ Reverse rotary

8. Use: __ Domestic __ Public supply __ Industry
__ Irrigation __ Air conditioning __ Stock
__ Lawn X Oil field water __ Other

9. Casing: Material Plastic Height: (Above) or below
Threaded __ Welded X Surface 1 in.
RMP __ PVC X Weight 387.3 lbs./ft.
Dia. 5 in. to 60 ft. depth Wall Thickness: inches or
Dia. __ in. to __ ft. depth gage No. 200

5. Type and color of material	From	To
Clay	0	15
Sandy Clay	15	30
Sand	30	40
Gravel	40	60

(Use a second sheet if needed)

10. Screen: Manufacturer's name Self made
Type PVC Dia. 5
Slot/gauze 3 Length 20
Set between 40 ft. and 60 ft.
ft. and ft.
Gravel pack? yes Size range of material ⅛ - 1

11. Static water level: mo./day/yr.
17 ft. below land surface Date 1-9-78

12. Pumping level below land surfaces:
ft. after hrs. pumping g.p.m.
ft. after hrs. pumping g.p.m.
Estimated maximum yield g.p.m.

13. Water sample submitted: mo./day/yr.
__ Yes X No Date

14. Well head completion:
__ Pitless adapter Inches above grade

15. Well grouted? yes
With: __ Neat cement X Bentonite __ Concrete
Depth: From 0 ft. to 10 ft.

16. Nearest source of possible contamination:
ft. Direction Type
Well disinfected upon completion? __ Yes __ No

17. Pump: X Not installed
Manufacturer's name
Model number HP Volts
Length of drop pipe ft. capacity g.p.m.
Type:
__ Submersible __ Turbine
__ Jet __ Reciprocating
__ Centrifugal __ Other

18. Elevation:
Topography:
__ Hill
X Slope
__ Upland
__ Valley

19. Remarks:

20. Water well contractor's certification:
This well was drilled under my jurisdiction and this report is true to the best of my knowledge and belief.
Meyer Water Well
Business name License No.
Address Ellinwood Ks 1443
Signed [signature] Date 1-9-78
Authorized representative

T 24 R 14 E Sec 25 C ½ NE ¼ SE ¼

Forward the white, blue and pink copies to the Department of Health and Environment

Form WWC-5

M1-1023