USE TYPEWRITER OR BALL POINT PEN-PRESS FIRMLY, PRINT CLEARLY.

WATER WELL RECORD
KSA 82a-1201-1215

Kansas Department of Health and Environment-Division of Environment
(Water well Contractors)
Topeko, Kansas 66620

1. Location of well: County: Stafford | Fraction: ~~SW~~ 1/4 NW 1/4 SE 1/4 | Section number: 33 | Township number: T 24 S | Range number: R 14 E W

2. Distance and direction from nearest town or city: Hwy #50 & Dillwyn Rd 3 miles South 1/2 EAST
Street address of well location if in city: 1/2 NORTH

3. Owner of well: Sterling Dclg.
R.R. or street: Box 129
City, state, zip code: Sterling Ks. 67579

4. Locate with "X" in section below: Sketch map:

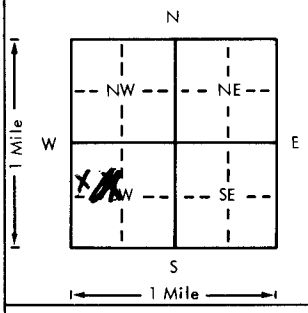

6. Bore hole dia. 9 in. Completion date
Well depth 60 ft. 10-26-78

7. ___ Cable tool X Rotary ___ Driven ___ Dug
___ Hollow rod ___ Jetted ___ Bored ___ Reverse rotary

8. Use: ___ Domestic ___ Public supply ___ Industry
___ Irrigation ___ Air conditioning ___ Stock
___ Lawn X Oil field water ___ Other

9. Casing: Material ___ Height: Above or below
Threaded ___ Welded X Surface 12 in.
RMP ___ PVC X Weight 278-3 lbs./ft.
Dia. 5 in. to 60 ft. depth Wall Thickness: inches or
Dia. ___ in. to ___ ft. depth gage No. 200, 265

10. Screen: Manufacturer's name Peerless
Type SAW Dia. 5
Slot/gauze 10 Length 20
Set between 60 ft. and 40 ft.
___ ft. and ___ ft.
Gravel pack? yes Size range of material 1/4-1/8

11. Static water level: ma./day/yr.
20 ft. below land surface Date 10-26-78

12. Pumping level below land surfaces:
___ ft. after ___ hrs. pumping ___ g.p.m.
___ ft. after ___ hrs. pumping ___ g.p.m.
Estimated maximum yield ___ g.p.m.

13. Water sample submitted: mo./day/yr.
___ Yes X No Date

14. Well head completion:
___ Pitless adapter 12 Inches above grade

15. Well grouted? yes
With: ___ Neat cement X Bentonite ___ Concrete
Depth: From 0 ft. to 10 ft.

16. Nearest source of possible contamination:
ft. ___ Direction ___ Type None
Well disinfected upon completion? ___ Yes ___ No

17. Pump: X Not installed
Manufacturer's name
Model number HP Volts
Length of drop pipe ft. capacity g.p.m.
Type:
___ Submersible ___ Turbine
___ Jet ___ Reciprocating
___ Centrifugal ___ Other

5. Type and color of material	From	To
Sandy Clay	0	18
Clay	18	30
Gravel	30	60

(Use a second sheet if needed)

18. Elevation:

Topography:
___ Hill
X Slope
___ Upland
___ Valley

19. Remarks:

20. Water well contractor's certification:
This well was drilled under my jurisdiction and this report is true to the best of my knowledge and belief.
Myers Water Well 143
Business name License No.
Address Great Bend Ks
Signed Floyd Rosendahl Date 10-26
Authorized representative

Forward the white, blue and pink copies to the Department of Health and Environment

Form WWC-5

MI-1023

24 T L 14 R E W 33 Sec SW 1/4 NW 1/4 SE 1/4