


1 LOCATION OF WATER WELL:		Fraction	Section Number	Township Number	Range Number
County:	Stafford	NE ¼ NE ¼ NE ¼	21	T 24 S	R 15 EW

Distance and direction from nearest town or city street address of well if located within city?

2	WATER WELL OWNER:	St. John Co-op	
	RR#, St. Address, Box # :	312 W. 1st. St.	Board of Agriculture, Division of Water Resources
	City, State, ZIP Code :	St. John, Ks 67576	MW3 Application Number:

3 LOCATE WELL'S LOCATION WITH AN "X" IN SECTION BOX: 4 DEPTH OF COMPLETED WELL... 30.0 ft. ELEVATION:
 Depth(s) Groundwater Encountered: ft. 2 ft. 2 ft. 2 ft. 2

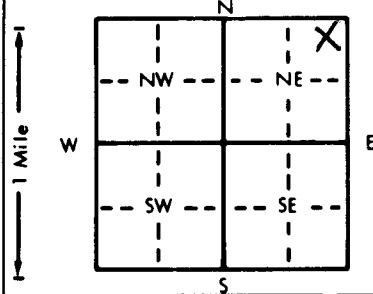

4 DEPTH OF COMPLETED WELL... 30.0 ... ft. ELEVATION: _____

Depth(s) Groundwater Encountered 1. _____ ft. 2. _____ ft. 3. _____ ft.

WELL'S STATIC WATER LEVEL 18.64 ... ft. below land surface measured on mo/day/yr _____

Pump test data: Well water was _____ ft. after _____ hours pumping _____ gpm

Est. Yield _____ gpm: Well water was _____ ft. after _____ hours pumping _____ gpm

Bore Hole Diameter... 8.5 in. to 30.0 ... ft., and _____ in. to _____ ft.

WELL WATER TO BE USED AS:

5 Public water supply	8 Air conditioning	11 Injection well		
1 Domestic	3 Feedlot	6 Oil field water supply	9 Dewatering	12 Other (Specify below)
2 Irrigation	4 Industrial	7 Lawn and garden only	10 Monitoring well	

Was a chemical/bacteriological sample submitted to Department? Yes.....No ☒..... If yes, mo/day/yr sample was submitted _____

Water Well Disinfected? Yes _____ No ☒

5	TYPE OF BLANK CASING USED:		5 Wrought iron	8 Concrete tile	CASING JOINTS: Glued . . x . . . Clamped Welded Threaded . . x
	1 Steel	3 RMP (SR)	6 Asbestos-Cement	9 Other (specify below)	
	2 PVC	4 ABS	7 Fiberglass		

Blank casing diameter 2 1/2 in. to 10.0 ft. Dia. in. to ft. Dia. in. to ft.
Casing height above land surface 0 in. weight 2.071 lbs./ft. Wall thickness or gauge No. .237

TYPE OF SCREEN OR PERFORATION MATERIAL:			7 PVC	10 Asbestos-cement
1 Steel	3 Stainless steel	5 Fiberglass	8 RMP (SR)	11 Other (specify)
2 Brass	4 Galvanized steel	6 Concrete tile	9 ABS	12 None used (open hole)

SCREEN OR PERFORATION OPENINGS ARE:			
1 Continuous slot	3 Mill slot	5 Gauzed wrapped	8 Saw cut
2 Louvered shutter	4 Key punched	6 Wire wrapped	9 Drilled holes
		7 Torch cut	10 Other (specify)
			11 None (open hole)

SCREEN-PERFORATED INTERVALS:	From	10	ft. to	30	ft., From	ft. to	ft.
	From		ft. to		ft., From	ft. to	ft.
GRAVEL PACK INTERVALS:	From	8	ft. to	30	ft., From	ft. to	ft.
	From		ft. to		ft., From	ft. to	ft.

6	GROUT MATERIAL:		1 Neat cement	2 Cement grout	3 Bentonite	4 Other
Grout Intervals: From 0 ft. to 4 ft., From 4 ft. to 8 ft., From ft. to ft.						

What is the nearest source of possible contamination:			10 Livestock pens	14 Abandoned water well
1 Septic tank	4 Lateral lines	7 Pit privy	11 Fuel storage	15 Oil well/Gas well
2 Sewer lines	5 Cess pool	8 Sewage lagoon	12 Fertilizer storage	16 Other (specify below)
3 Watertight sewer lines	6 Seepage pit	9 Feedyard	13 Insecticide storage	Contaminated Site
Direction from well?			How many feet?	

[illegible]

7 CONTRACTOR'S OR LANDOWNER'S CERTIFICATION: This water well was (1) constructed, (2) reconstructed, or (3) plugged under my jurisdiction and was completed on (mo/day/year) ... 12-07-99 ... and this record is true to the best of my knowledge and belief. Kansas Water Well Contractor's License No. 554 This Water Well Record was completed on (mo/day/yr) 01-10-2000 under the business name of Woofter Pump & Well Inc. by (signature) 