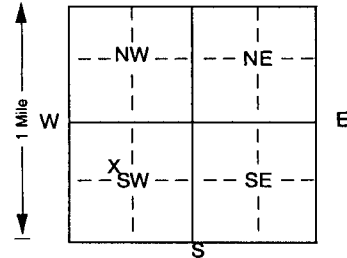


1 LOCATION OF WATER WELL:	Fraction	Section Number	Township Number	Range Number
County: Stafford	SE 1/4 NW 1/4 SW 1/4	15	T 24 S	R 15 E (W)

Distance and direction from nearest town or city street address of well if located within city?

East of the intersection of Central and Gilmore

2 WATER WELL OWNER: USD #351	Board of Agriculture, Division of Water Resources
RR#, St. Address, Box # : P.O. Box 487	Application Number:
City, State, ZIP Code : Macksville, KS 67557	

3 LOCATE WELL'S LOCATION WITH AN "X" IN SECTION BOX:	4 DEPTH OF COMPLETED WELL 81 ft. ELEVATION: unknown
	Depth(s) Groundwater Encountered 1 ft. 2 ft. 3 ft. ft.
	WELL'S STATIC WATER LEVEL not checked ft. below land surface measured on mo/day/yr
	Pump test data: Well water was not checked ft. after hours pumping gpm
	Est. Yield unknown gpm: Well water was ft. after hours pumping gpm
	Bore Hole Diameter 14 in. to 81 ft., and in. to ft.
	WELL WATER TO BE USED AS: 5 Public water supply 8 Air conditioning 11 Injection well
	1 Domestic 3 Feedlot 6 Oil field water supply 9 Dewatering 12 Other (specify below)
	2 Irrigation 4 Industrial (7) Domestic (lawn & garden) 10 Monitoring well
	Was a chemical/bacteriological sample submitted to Department? Yes No (checked) If yes, mo/day/yr sample was submitted
	Water Well Disinfected? Yes No (checked)

5 TYPE OF BLANK CASING USED:	5 Wrought iron	8 Concrete tile	CASING JOINTS: Glued (checked) Clamped
1 Steel	3 RMP (SR)	6 Asbestos-Cement	9 Other (specify below)
(2) PVC	4 ABS	7 Fiberglass	Welded
			Threaded
Blank casing diameter 8 in. to 64 ft., Dia			
Casing height above land surface 24 in., weight 5.59 lbs./ft.			Wall thickness or gauge No .332
TYPE OF SCREEN OR PERFORATION MATERIAL:	7 PVC	10 Asbestos-cement	
1 Steel	(3) Stainless steel	5 Fiberglass	8 RMP (SR)
2 Brass	4 Galvanized steel	6 Concrete tile	9 ABS
SCREEN OR PERFORATION OPENINGS ARE:	5 Gauzed wrapped	8 Saw cut	11 None (open hole)
(1) Continuous slot	3 Mill slot	6 Wire wrapped	9 Drilled holes
2 Louvered shutter	4 Key punched	7 Torch cut	10 Other (specify)
SCREEN-PERFORATED INTERVALS:	From 64 ft. to 79 ft., From		
	From ft. to ft., From		
GRAVEL PACK INTERVALS:	From 55 ft. to 81 ft., From		
	From ft. to ft., From		

6 GROUT MATERIAL:	1 Neat cement	2 Cement grout	3 Bentonite	4 Other Bentonite Holeplug
Grout Intervals: From ft. to ft., From ft. to ft., From 0 ft. to 55 ft.				
What is the nearest source of possible contamination:				
1 Septic tank	4 Lateral lines	7 Pit privy	10 Livestock pens	14 Abandoned water well
2 Sewer lines	5 Cess pool	8 Sewage lagoon	11 Fuel storage	15 Oil well/Gas well
3 Watertight sewer lines	6 Seepage pit	9 Feedyard	12 Fertilizer storage	16 Other (specify below)
			13 Insecticide storage	None known
Direction from well?			How many feet?	

FROM	TO	LITHOLOGIC LOG	FROM	TO	PLUGGING INTERVALS
0	5	Topsoil	74	81	Gravel, coarse, very hard
5	8	Clay, tannish brown, soft, sandy			
8	20	Sand, medium to fine with clay streaks			
20	43	Clay, brown, soft, sandy with sand, very fine			
43	49.5	Clay, light gray, soft			
49.5	51	Sand, very fine			
51	55	Sand, very fine with streaks of clay and gravel			
55	56	Sand, loose			
56	57	Cemented sand, hard			
57	61	Sand, very fine, silty, dirty			
61	65	Sand and gravel, fine and loose			
65	70	Sand and gravel, fine to medium, clean, loose			
70	74	Sand and gravel, medium to coarse with thin			
		cemented sand streaks and gravel, loose			

7 CONTRACTOR'S OR LANDOWNER'S CERTIFICATION: This water well was (1) constructed (2) reconstructed or (3) plugged under my jurisdiction and was completed on (mo/day/year) 6-18-03 and this record is true to the best of my knowledge and belief. Kansas Water Well Contractor's License No 185 This Water Well Record was completed on (mo/day/yr) 6-19-03 under the business name of Clarke Well & Equipment, Inc. by (signature) [Signature]
--