

1 LOCATION OF WATER WELL: Fraction Section Number Township Number Range Number
 County: Stafford NE $\frac{1}{4}$ NE $\frac{1}{4}$ SW $\frac{1}{4}$ 22 T 24 S R 15W EW


Distance and direction from nearest town or city street address of well if located within city?

1/2S of Macksville, Ks.

2 WATER WELL OWNER Rollin Suiter Sterling Drilling Company Suiter #1
 RR#, St. Address, Box # General Delivery P. O. Box 1006 Board of Agriculture, Division of Water Resources
 City, State, ZIP Code Macksville, KS 67557 Pratt, Ks. 67124 Application Number: 20030117

3 LOCATE WELL'S LOCATION WITH 4 DEPTH OF COMPLETED WELL... 78 ft. ELEVATION: unknown

AN "X" IN SECTION BOX:

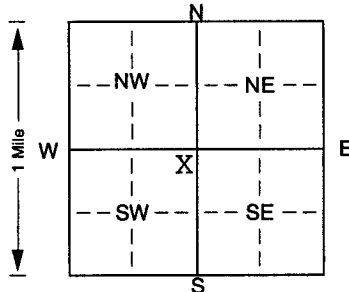

Depth(s) Groundwater Encountered 1... 35 ft. 2... ft. 3... ft.

WELL'S STATIC WATER LEVEL... 35 ft. below land surface measured on mo/day/yr 07/10/03

Pump test data: Well water was ... ft. after ... hours pumping ... gpm

Est. Yield ... 65 gpm: Well water was ... ft. after ... hours pumping ... gpm

Bore Hole Diameter... 8 in. to 78 ft., and... in. to ... ft.

WELL WATER TO BE USED AS: 5 Public water supply 8 Air conditioning 11 Injection well

1 Domestic 3 Feedlot 6 Oil field water supply 9 Dewatering 12 Other (Specify below)

2 Irrigation 4 Industrial 7 Domestic (lawn & garden) 10 Monitoring well

Was a chemical/bacteriological sample submitted to Department? Yes... No...; If yes, mo/day/yr sample was submitted
 Water Well Disinfected? Yes No

5 TYPE OF BLANK CASING USED: 5 Wrought iron 8 Concrete tile CASING JOINTS: Glued Clamped...

1 Steel 3 RMP (SR) 6 Asbestos-Cement 9 Other (specify below) Welded...

2 PVC 4 ABS 7 Fiberglass Threaded...

Blank casing diameter... 5 in. to 58 ft., Dia... in. to ... ft., Dia... in. to ... ft.

Casing height above land surface... 12 in., weight... 2.8 lbs./ft. Wall thickness or gauge No. Sch. 40

TYPE OF SCREEN OR PERFORATION MATERIAL: 7 PVC 10 Asbestos-cement

1 Steel 3 Stainless steel 5 Fiberglass 8 RMP (SR) 11 Other (specify)

2 Brass 4 Galvanized steel 6 Concrete tile 9 ABS 12 None used (open hole)

SCREEN OR PERFORATION OPENINGS ARE: 5 Gauzed wrapped 8 Saw cut 11 None (open hole)

1 Continuous slot 3 Mill slot 6 Wire wrapped 9 Drilled holes

2 Louvered shutter 4 Key punched 7 Torch cut 10 Other (specify) ... ft.

SCREEN-PERFORATED INTERVALS: From... 58 ft. to 78 ft., From... ft. to ... ft.

From... ft. to ... ft., From... ft. to ... ft.

GRAVEL PACK INTERVALS: From... 20 ft. to 78 ft., From... ft. to ... ft.

From... ft. to ... ft., From... ft. to ... ft.

6 GROUT MATERIAL: 1 Neat cement 2 Cement grout 3 Bentonite 4 Other

Grout Intervals: From... 0 ft. to 20 ft., From... ft. to ... ft., From... ft. to ... ft.

What is the nearest source of possible contamination: 10 Livestock pens 14 Abandoned water well

1 Septic tank 4 Lateral lines 7 Pit privy 11 Fuel storage 15 Oil well/Gas well

2 Sewer lines 5 Cess pool 8 Sewage lagoon 12 Fertilizer storage 16 Other (specify below)

3 Watertight sewer lines 6 Seepage pit 9 Feedyard 13 Insecticide storage

Direction from well? East How many feet? 120

FROM TO LITHOLOGIC LOG FROM TO PLUGGING INTERVALS

0 12 top sand

12 61 clay

61 78 sand and gravel

7 CONTRACTOR'S OR LANDOWNER'S CERTIFICATION: This water well was (1) constructed, (2) reconstructed, or (3) plugged under my jurisdiction and was completed on (mo/day/year) ... 07/10/03 ... and this record is true to the best of my knowledge and belief. Kansas

Water Well Contractor's Licence No. ... 186 ... This Water Well Record was completed on (mo/day/yr) ... 07/24/03 ...

under the business name of Kelly's Water Well Service, Inc. by (signature) Kathryn L. Wood