172 6528 WATER WELL PLUGGING RECORD Form WWC-5P KSA82a-1212 ID NO. Football Field

1 LOCATION OF WATER WELL: County: Stafford | Fraction: SE 1/4 NW 1/4 SW 1/4 | Section Number: 15 | Township Number: T 24 S | Range Number: R 15 E (W)

Distance and direction from nearest town or city street address of well if located within city?
East of the intersection of Central and Gilmore

2 WATER WELL OWNER: USD #351
RR#, St. Address, Box # P.O. Box 487
City, State, ZIP Code Macksville, KS 67557
Board of Agriculture, Division of Water Resources Application Number:

3 MARK WELL'S LOCATION WITH AN "X" IN SECTION BOX:

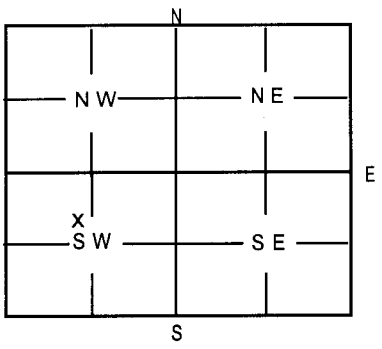

4 DEPTH OF WELL 77.7 ft
WELL'S STATIC WATER LEVEL 24.2 ft.
WELL WAS USED AS:
1 Domestic 5 Public Water Supply 9 Dewatering
2 Irrigation 6 Oil Field Water Supply 10 Monitoring Well
3 Feedlot 7 Domestic (Lawn & Garden) 11 Injection Well
4 Industrial 8 Air Conditioning 12 Other
Was a chemical / bacteriological sample submitted to Department? Yes No ✓
If yes, mo/day/yr sample was submitted
Water Well Disinfected: Yes ✓ No

5 TYPE OF BLANK CASING USED:
1 Steel 3 RMP (SR) 5 Wrought 7 Fiberglass 9 Other (Specify below)
2 PVC 4 ABS 6 Asbestos-Cement 8 Concrete Tile
Blank casing diameter 10 in. Was casing pulled? Yes No ✓ If yes, how much Cut off
Casing height above or (below) land surface 48 in.

6 GROUT PLUG MATERIAL: 1 Neat Cement 2 Cement grout 3 Bentonite 4 Other Bentonite Holeplug
Grout Plug Intervals: From ft. to ft., From ft. to ft. From 24 ft. to 4 ft.
What is the nearest source of possible contamination:
1 Septic tank 6 Seepage pit 11 Fuel storage 16 Other (specify below)
2 Sewer lines 7 Pit privy 12 Fertilizer storage None known
3 Watertight sewer lines 8 Sewage lagoon 13 Insecticide storage
4 Lateral lines 9 Feedyard 14 Abandoned water well
5 Cess Pool 10 Livestock pens 15 Oil well/Gas well
Direction from well? How many feet?

FROM	TO	PLUGGING MATERIALS
77.7	24	Chlorinated Sand
24	4	Bentonite Holeplug
4	0	Compacted Soil

7 CONTRACTOR'S OR LANDOWNER'S CERTIFICATION: This water well was plugged under my jurisdiction and was completed on (mo/day/year) 9-5-03 and this record is true to the best of my knowledge and belief. Kansas Water Well Contractor's License No. 185 This Water Well Record was completed on (mo/day/year) 9-17-03 under the business name of Clarke Well & Equipment, Inc.
by (signature)

INSTRUCTIONS: Use typewriter or ball point pen. Please press firmly and print clearly. Please fill in blanks, underline or circle the correct answers. Send top three copies to Kansas Department of Health & Environment, Bureau of Water, Topeka, Kansas 66620-0001. Telephone: 785/296-3565. Send one to Water Well Owner and retain one for your records.