Converted

WATER WELL PLUGGING RECORD Form WWC-5P KSA 82a-1212 ID No. MW-2

1 LOCATION OF WATER WELL: County: Stafford	Fraction NW ¼ NW ¼ NW ¼	Section Number 22	Township Number 24 S	Range Number 15 W

Distance and direction from nearest town or city street address of well if located within city?
132 East Broadway, Macksville, KS

2 WATER WELL OWNER: Kinzie Corporation
RR#, St. Address, Box # PO Box 464
City, State, ZIP Code : Macksville, KS 67557

Board of Agriculture, Division of Water Resources
Application Number:

3 MARK WELL'S LOCATON WITH AN "X" IN SECTION BOX:

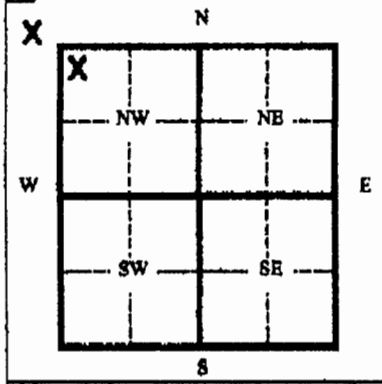

4 DEPTH OF WELL 28.52 ft.

WELL'S STATIC WATER LEVEL 20.41 ft.

WELL WAS USED AS:

1 Domestic 5 Public Water Supply 9 Dewatering
2 Irrigation 6 Oil Field Water Supply (10) Monitoring Well
3 Feedlot 7 Lawn and Garden (domestic) 11 Injection Well
4 Industrial 8 Air Conditioning 12 Other

Was a chemical/bacteriological sample submitted to Department? Yes ___ No ___
If yes, mo/day/yr sample was submitted
Water Well Disinfected: Yes ___ No ___

5 TYPE OF BLANK CASING USED:
1 Steel 3 RMP (SR) 5 Wrought 7 Fiberglass 9 Other (specify below)
(2) PVC 4 ABC 6 Asbestos-Cement 8 Concrete Tile

Blank casing diameter 2 in. Was casing pulled? Yes X No ___ If yes, how much removed 3 ft.

Casing height above or below land surface -36 in.

6 GROUT PLUG MATERIAL: 1 Neat cement 2 Cement grout (3) Bentonite 4 Other

Grout Plug Intervals From 0 ft. to 28.52 ft. From ___ ft. to ___ ft. From ___ ft. to ___ ft.

What is the nearest source of possible contamination:

1 Septic tank 6 Seepage pit (11) Fuel storage 16 Other (specify below)
2 Sewer lines 7 Pit privy 12 Fertilizer storage
3 Watertight sewer lines 8 Sewage lagoon 13 Insecticide storage
4 Lateral lines 9 Feedyard 14 Abandoned water well
5 Cess Pool 10 Livestock pens 15 Oil well/ Gas well

Direction from well? How many feet?

FROM	TO	CODE	PLUGGING MATERIALS
0	28.52		Bentonite grout

RECEIVED
JAN 08 2009
BUREAU OF WATER

7 CONTRACTOR'S OR LANDOWNER'S CERTIFICATION: This water well was plugged under my jurisdiction and was completed on (mo/day/yr) 11/6/08 and this record is true to the best of my knowledge and belief. Kansas Water Well Contractor's License No. 554 This Water Well Record was completed on (mo/day/yr) 11/17/08 under the business name of Bluestem Environmental Engineering, Inc.
by (signature) Nick Hitt Gary R. Wright

INSTRUCTIONS: Please fill in blanks and circle the correct answers. Send three copies to Kansas Department of Health and Environment, Bureau of Water, 1000 S W Jackson St., Ste. 420, Topeka, Kansas 66620-0001. Telephone: 785-296-3565. Send one to Water Well Owner and retain one for your records.

Form provided by Forms On-A-Disk, Inc. • Dallas, Texas • (214) 340-9429