

WATER WELL PLUGGING RECORD

Form WWC-5P


KSA 82a-1212

ID No.

Corrected
AS-5R

1 LOCATION OF WATER WELL: Fraction SW 1/4 SW 1/4 SW 1/4 Section Number 22 Township Number 24 S Range Number 15 W
 County: Stafford
 Distance and direction from nearest town or city street address of well if located within city?
102 East Broadway, Macksville, KS

2 WATER WELL OWNER: David Deighton
 RR#, St. Address, Box # PO Box 66 Board of Agriculture, Division of Water Resources
 City, State, ZIP Code Macksville, KS 67557 Application Number:

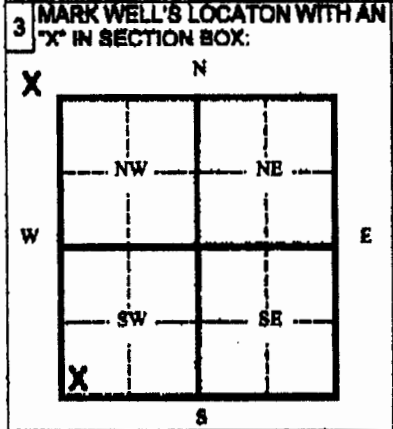

4 DEPTH OF WELL 40.18 ft.
 WELL'S STATIC WATER LEVEL 21.10 ft.
 WELL WAS USED AS:
 1 Domestic 5 Public Water Supply 9 Dewatering
 2 Irrigation 8 Oil Field Water Supply 10 Monitoring Well
 3 Feedlot 7 Lawn and Garden (domestic) **11 Injection Well**
 4 Industrial 8 Air Conditioning 12 Other

Was a chemical/bacteriological sample submitted to Department? Yes ___ No ___
 If yes, mo/day/yr sample was submitted _____
 Water Well Disinfected: Yes ___ No ___

5 TYPE OF BLANK CASING USED:
 1 Steel 3 RMP (SR) 5 Wrought 7 Fiberglass 9 Other (specify below)
2 PVC 4 ABC 6 Asbestos-Cement 8 Concrete Tile
 Blank casing diameter 2 in. Was casing pulled? Yes X No ___ If yes, how much removed 3 ft.
 Casing height above or below land surface - 36 in.

6 GROUT PLUG MATERIAL: 1 Neat cement 2 Cement grout **3 Bentonite** 4 Other
 Grout Plug Intervals From 0 ft. to 40.18 ft. From ___ ft. to ___ ft. From ___ ft. to ___ ft.
 What is the nearest source of possible contamination:
 1 Septic tank 6 Seepage pit **11 Fuel storage** 16 Other (specify below)
 2 Sewer lines 7 Pit privy 12 Fertilizer storage
 3 Watertight sewer lines 8 Sewage lagoon 13 Insecticide storage
 4 Lateral lines 9 Feedyard 14 Abandoned water well
 5 Cess Pool 10 Livestock pens 15 Oil well/ Gas well

Direction from well? _____ How many feet? _____

FROM	TO	CODE	PLUGGING MATERIALS
0	40.18		Bentonite grout

RECEIVED
 JAN 08 2009
BUREAU OF WATER

7 CONTRACTOR'S OR LANDOWNER'S CERTIFICATION: This water well was plugged under my jurisdiction and was completed on (mo/day/yr) 11/4/08 and this record is true to the best of my knowledge and belief. Kansas Water Well Contractor's License No. 554 This Water Well Record was completed on (mo/day/yr) 11/17/08 under the business name of Nieldent Bluestem Environmental Engineering, Inc.
 by (signature) [Signature]

INSTRUCTIONS: Please fill in blanks and circle the correct answers. Send three copies to Kansas Department of Health and Environment, Bureau of Water, 1000 S W Jackson St., Ste. 420, Topeka, Kansas 66620-0001. Telephone: 785-298-3565. Send one to Water Well Owner and retain one for your records.