

Corrected
AS-8

WATER WELL PLUGGING RECORD

Form WWC-5P

KSA 82a-1212

ID No.

AS-8


1 LOCATION OF WATER WELL: County: <u>Stafford</u>	Fraction <u>SW 1/4 SW 1/4 SW 1/4</u>	Section Number <u>22</u>	Township Number <u>24 S</u>	Range Number <u>15 W</u>
--	---	-----------------------------	--------------------------------	-----------------------------

Distance and direction from nearest town or city street address of well if located within city?
132 East Broadway, Macksville, KS

2 WATER WELL OWNER: Dean Kinzie
 RR#, St. Address, Box # PO Box 464
 City, State, ZIP Code Macksville, KS 67557
 Board of Agriculture, Division of Water Resources
 Application Number:

3 MARK WELL'S LOCATION WITH AN "X" IN SECTION BOX:

4 DEPTH OF WELL 29.4 ft.
 WELL'S STATIC WATER LEVEL 20.22 ft.

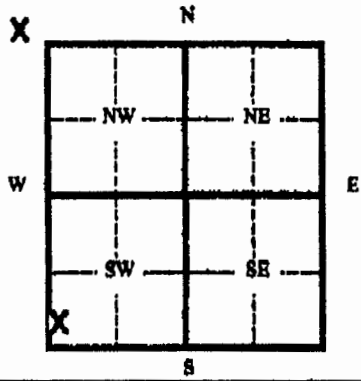

WELL WAS USED AS:

1 Domestic	5 Public Water Supply	9 Dewatering
2 Irrigation	6 Oil Field Water Supply	10 Monitoring Well
3 Feedlot	7 Lawn and Garden (domestic)	11 Injection Well
4 Industrial	8 Air Conditioning	12 Other

Was a chemical/bacteriological sample submitted to Department? Yes ___ No ___
 If yes, mo/day/yr sample was submitted _____
 Water Well Disinfected: Yes ___ No ___

5 TYPE OF BLANK CASING USED:

1 Steel	3 RMP (SR)	5 Wrought	7 Fiberglass	9 Other (specify below)
2 PVC	4 ABC	6 Asbestos-Cement	8 Concrete Tile	

Blank casing diameter 2 in. Was casing pulled? Yes No ___ If yes, how much removed 3 ft.
 Casing height above or below land surface -36 in.

6 GROUT PLUG MATERIAL: 1 Neat cement 2 Cement grout 3 Bentonite 4 Other

Grout Plug Intervals From 0 ft. to 29.4 ft. From ___ ft. to ___ ft. From ___ ft. to ___ ft.

What is the nearest source of possible contamination:

1 Septic tank	6 Seepage pit	11 Fuel storage	16 Other (specify below)
2 Sewer lines	7 Pit privy	12 Fertilizer storage	
3 Watertight sewer lines	8 Sewage lagoon	13 Insecticide storage	
4 Lateral lines	9 Feedyard	14 Abandoned water well	
5 Cess Pool	10 Livestock pens	15 Oil well/ Gas well	

Direction from well? _____ How many feet? _____

FROM	TO	CODE	PLUGGING MATERIALS
0	29.4		Bentonite grout

RECEIVED
JAN 08 2009
BUREAU OF WATER

7 CONTRACTOR'S OR LANDOWNER'S CERTIFICATION: This water well was plugged under my jurisdiction and was completed on (mo/day/yr) 11/5/08 and this record is true to the best of my knowledge and belief. Kansas Water Well Contractor's License No. 554 This Water Well Record was completed on (mo/day/yr) 11/17/08 under the business name of Nildt Bluestem Environmental Engineering, Inc. by (signature) [Signature]

INSTRUCTIONS: Please fill in blanks and circle the correct answers. Send three copies to Kansas Department of Health and Environment, Bureau of Water, 1000 S W Jackson St., Ste. 420, Topeka, Kansas 66620-0001. Telephone: 785-298-3585. Send one to Water Well Owner and retain one for your records.