

*Corrected*  
AS-10R

WATER WELL PLUGGING RECORD

Form WWC-5P


KSA 82a-1212

ID No.

|  |   |                             |                                |                             |
|--|---|-----------------------------|--------------------------------|-----------------------------|
| 1 LOCATION OF WATER WELL:<br>County: <u>Stafford</u> | Fraction<br><u>SW 1/4 SW 1/4 SW 1/4</u> | Section Number<br><u>22</u> | Township Number<br><u>24 S</u> | Range Number<br><u>15 W</u> |
|--|---|-----------------------------|--------------------------------|-----------------------------|

Distance and direction from nearest town or city street address of well if located within city?  
102 East Broadway, Macksville, KS

2 WATER WELL OWNER: David Deighton  
 RR#, St. Address, Box # PO Box 66  
 City, State, ZIP Code Macksville, KS 67557  
 Board of Agriculture, Division of Water Resources  
 Application Number: \_\_\_\_\_

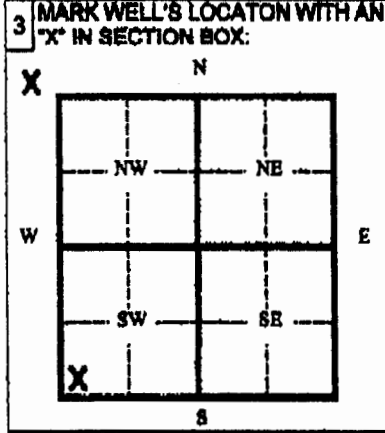

4 DEPTH OF WELL 41.30 ft.  
 WELL'S STATIC WATER LEVEL 24.04 ft.  
 WELL WAS USED AS:  
 1 Domestic      5 Public Water Supply      9 Dewatering  
 2 Irrigation    6 Oil Field Water Supply    10 Monitoring Well  
 3 Feedlot       7 Lawn and Garden (domestic)   11 Injection Well  
 4 Industrial    8 Air Conditioning            12 Other \_\_\_\_\_  
 Was a chemical/bacteriological sample submitted to Department? Yes \_\_\_ No \_\_\_  
 If yes, mo/day/yr sample was submitted \_\_\_\_\_  
 Water Well Disinfected: Yes \_\_\_ No \_\_\_

5 TYPE OF BLANK CASING USED:  
 1 Steel      3 RMP (SR)      5 Wrought      7 Fiberglass      9 Other (specify below)  
 2 PVC      4 ABC      6 Asbestos-Cement      8 Concrete Tile  
 Blank casing diameter 2 in. Was casing pulled? Yes  No \_\_\_ If yes, how much removed 3 ft.  
 Casing height above or below land surface -36 in.

6 GROUT PLUG MATERIAL: 1 Neat cement    2 Cement grout    3 Bentonite    4 Other \_\_\_\_\_  
 Grout Plug Intervals From 0 ft. to 41.30 ft. From \_\_\_\_\_ ft. to \_\_\_\_\_ ft. From \_\_\_\_\_ ft. to \_\_\_\_\_ ft.  
 What is the nearest source of possible contamination:  
 1 Septic tank      6 Seepage pit      11 Fuel storage      16 Other (specify below)  
 2 Sewer lines    7 Pit privy        12 Fertilizer storage  
 3 Watertight sewer lines    8 Sewage lagoon    13 Insecticide storage  
 4 Lateral lines    9 Feedyard        14 Abandoned water well  
 5 Cess Pool        10 Livestock pens    15 Oil well/ Gas well  
 Direction from well? \_\_\_\_\_ How many feet? \_\_\_\_\_

| FROM | TO    | CODE | PLUGGING MATERIALS |
|------|-------|------|--------------------|
| 0    | 41.30 |      | Bentonite grout    |
|      |       |      |                    |
|      |       |      |                    |
**RECEIVED**  
JAN 08 2009  
**BUREAU OF WATER**

7 CONTRACTOR'S OR LANDOWNER'S CERTIFICATION: This water well was plugged under my jurisdiction and was completed on (mo/day/yr) 11/4/08 and this record is true to the best of my knowledge and belief. Kansas Water Well Contractor's License No. 254 This Water Well Record was completed on (mo/day/yr) 11/17/08 under the business name of Bluestem Environmental Engineering, Inc.  
 by (signature) *David Deighton* *Jay C. Williams*

INSTRUCTIONS: Please fill in blanks and circle the correct answers. Send three copies to Kansas Department of Health and Environment, Bureau of Water, 1000 S W Jackson St., Ste. 420, Topeka, Kansas 66620-0001. Telephone: 785-298-3586. Send one to Water Well Owner and retain one for your records.