

*Corrected*

WATER WELL PLUGGING RECORD

Form WWC-5P

KSA 82a-1212

ID No.

AS-11

1 LOCATION OF WATER WELL: County: <u>Stafford</u>	Fraction <u>SW 1/4 SW 1/4 SW 1/4</u>	Section Number <u>22</u>	Township Number <u>24 S</u>	Range Number <u>15 W</u>
--	---	-----------------------------	--------------------------------	-----------------------------

Distance and direction from nearest town or city street address of well if located within city?  
132 East Broadway, Macksville, KS

2 WATER WELL OWNER: Dean Kinzie  
 RR#, St. Address, Box # PO Box 464  
 City, State, ZIP Code Macksville, KS 67557  
 Board of Agriculture, Division of Water Resources  
 Application Number:

3 MARK WELL'S LOCATION WITH AN "X" IN SECTION BOX:

4 DEPTH OF WELL 33.15 ft.

WELL'S STATIC WATER LEVEL \_\_\_\_\_ ft.


WELL WAS USED AS:

- |              |                              |  |
|--------------|------------------------------|--|
| 1 Domestic   | 5 Public Water Supply        | 9 Dewatering                                       |
| 2 Irrigation | 6 Oil Field Water Supply     | 10 Monitoring Well                                 |
| 3 Feedlot    | 7 Lawn and Garden (domestic) | <input checked="" type="radio"/> 11 Injection Well |
| 4 Industrial | 8 Air Conditioning           | 12 Other _____                                     |

Was a chemical/bacteriological sample submitted to Department? Yes \_\_\_ No \_\_\_

If yes, mo/day/yr sample was submitted \_\_\_\_\_

Water Well Disinfected: Yes \_\_\_ No \_\_\_

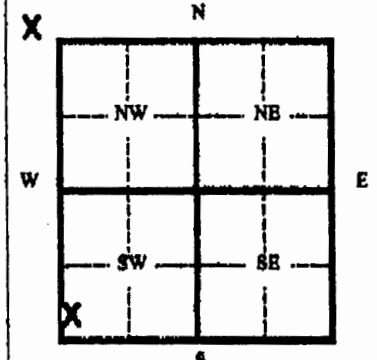

5 TYPE OF BLANK CASING USED:  
 1 Steel      3 RMP (SR)      5 Wrought      7 Fiberglass      9 Other (specify below)  
 2 PVC      4 ABC      6 Asbestos-Cement      8 Concrete Tile  
 Blank casing diameter 2 in. Was casing pulled? Yes  No \_\_\_ If yes, how much removed 3 ft.  
 Casing height above or below land surface -36 in.

6 GROUT PLUG MATERIAL: 1 Neat cement    2 Cement grout     3 Bentonite    4 Other \_\_\_\_\_  
 Grout Plug intervals From 0 ft. to 33.15 ft. From \_\_\_\_\_ ft. to \_\_\_\_\_ ft. From \_\_\_\_\_ ft. to \_\_\_\_\_ ft.

What is the nearest source of possible contamination:

- |                          |                   |  |                          |
|--------------------------|-------------------|--|--------------------------|
| 1 Septic tank            | 6 Seepage pit     | <input checked="" type="radio"/> 11 Fuel storage | 16 Other (specify below) |
| 2 Sewer lines            | 7 Pit privy       | 12 Fertilizer storage                            |                          |
| 3 Watertight sewer lines | 8 Sewage lagoon   | 13 Insecticide storage                           |                          |
| 4 Lateral lines          | 9 Feedyard        | 14 Abandoned water well                          |                          |
| 5 Cess Pool              | 10 Livestock pens | 15 Oil well/ Gas well                            |                          |

Direction from well? \_\_\_\_\_ How many feet? \_\_\_\_\_

FROM	TO	CODE	PLUGGING MATERIALS
0	33.15		Bentonite grout

RECEIVED

JAN 08 2009

BUREAU OF WATER

7 CONTRACTOR'S OR LANDOWNER'S CERTIFICATION: This water well was plugged under my jurisdiction and was completed on (mo/day/yr) 11/5/08 and this record is true to the best of my knowledge and belief. Kansas Water Well Contractor's License No. 554 This Water Well Record was completed on (mo/day/yr) 11/17/08 under the business name of Bluestem Environmental Engineering, Inc. by (signature) *Nick Doherty*

INSTRUCTIONS: Please fill in blanks and circle the correct answers. Send three copies to Kansas Department of Health and Environment, Bureau of Water, 1000 S W Jackson St., Ste. 420, Topeka, Kansas 66620-0001. Telephone: 785-296-3566. Send one to Water Well Owner and retain one for your records.