

WATER WELL PLUGGING RECORD

Form WWC-5P

KSA 82a-1212

ID No.

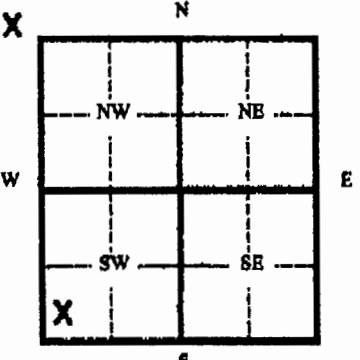
MW-14

Corrected

1 LOCATION OF WATER WELL: County: <u>Stafford</u>	Fraction <u>SW 1/4 SW 1/4 SW 1/4</u>	Section Number <u>15 W</u>	Township Number <u>24 S</u>	Range Number <u>15 W</u>
--	---	-------------------------------	--------------------------------	-----------------------------

Distance and direction from nearest town or city street address of well if located within city?
132 East Broadway, Macksville, KS

2 WATER WELL OWNER: <u>Kinzie Corporation</u> RR#, St. Address, Box # <u>PO Box 464</u> City, State, ZIP Code <u>Macksville, KS 67557</u>	Board of Agriculture, Division of Water Resources Application Number:
---	--

3 MARK WELL'S LOCATION WITH AN "X" IN SECTION BOX: 	4 DEPTH OF WELL <u>27.68</u> ft. WELL'S STATIC WATER LEVEL <u>20.7</u> ft. WELL WAS USED AS: 1 Domestic 5 Public Water Supply 9 Dewatering 2 Irrigation 8 Oil Field Water Supply 10 Monitoring Well 3 Feedlot 7 Lawn and Garden (domestic) 11 Injection Well 4 Industrial 8 Air Conditioning 12 Other _____ Was a chemical/bacteriological sample submitted to Department? Yes ___ No ___ If yes, mo/day/yr sample was submitted _____ Water Well Disinfected: Yes ___ No ___
--	--

5 TYPE OF BLANK CASING USED:
1 Steel 3 RMP (SR) 5 Wrought 7 Fiberglass 9 Other (specify below)
2 PVC 4 ABC 6 Asbestos-Cement 8 Concrete Tile
Blank casing diameter 2 in. Was casing pulled? Yes X No ___ If yes, how much removed 5 ft.
Casing height above or below land surface -36 in.

6 GROUT PLUG MATERIAL: 1 Neat cement 2 Cement grout 3 Bentonite 4 Other _____
Grout Plug Intervals From 0 ft. to 27.68 ft. From _____ ft. to _____ ft. From _____ ft. to _____ ft.
What is the nearest source of possible contamination:
1 Septic tank 6 Seepage pit 11 Fuel storage 16 Other (specify below)
2 Sewer lines 7 Pit privy 12 Fertilizer storage
3 Watertight sewer lines 8 Sewage lagoon 13 Insecticide storage
4 Lateral lines 9 Feedyard 14 Abandoned water well
5 Cess Pool 10 Livestock pens 15 Oil well/ Gas well
Direction from well? _____ How many feet? _____

FROM	TO	CODE	PLUGGING MATERIALS
0	27.68		Bentonite grout

7 CONTRACTOR'S OR LANDOWNER'S CERTIFICATION: This water well was plugged under my jurisdiction and was completed on (mo/day/yr) 11/6/08 and this record is true to the best of my knowledge and belief. Kansas Water Well Contractor's License No. 554 This Water Well Record was completed on (mo/day/yr) 11/17/08 under the business name of Bluestem Environmental Engineering, Inc. by (signature) Nick Holt Greg C. Holt

INSTRUCTIONS: Please fill in blanks and circle the correct answers. Send three copies to Kansas Department of Health and Environment, Bureau of Water, 1000 S W Jackson St., Ste. 420, Topeka, Kansas 66620-0001. Telephone: 785-298-3586. Send one to Water Well Owner and retain one for your records.

RECEIVED

JAN 08 2009

BUREAU OF WATER