Corrected

WATER WELL PLUGGING RECORD Form WWC-5P KSA 82a-1212 ID No. SVE-7*

| 1 LOCATION OF WATER WELL: | Fraction | Section Number | Township Number | Range Number |
|---|---|---|---|---|
| County: Stafford | SW ¼ SW ¼ SW ¼ | 22 | 24 S | 15 W |

Distance and direction from nearest town or city street address of well if located within city?
102 East Broadway, Macksville, KS

2 WATER WELL OWNER: David Deighton
RR#, St. Address, Box #: PO Box 66
City, State, ZIP Code: Macksville, KS 67557
Board of Agriculture, Division of Water Resources Application Number:

3 MARK WELL'S LOCATON WITH AN "X" IN SECTION BOX:

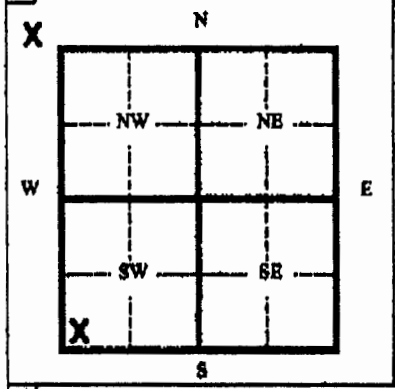


4 DEPTH OF WELL 23.75 ft.
WELL'S STATIC WATER LEVEL ft.

*Well installed as SVE-7, renamed SVE-1R

WELL WAS USED AS:

| | | |
|---|---|---|
| 1 Domestic | 5 Public Water Supply | 9 Dewatering |
| 2 Irrigation | 6 Oil Field Water Supply | 10 Monitoring Well |
| 3 Feedlot | 7 Lawn and Garden (domestic) | 11 Injection Well |
| 4 Industrial | 8 Air Conditioning | (12) Other Soil Vapor |

Was a chemical/bacteriological sample submitted to Department? Yes ___ No ___
If yes, mo/day/yr sample was submitted
Water Well Disinfected: Yes ___ No ___

5 TYPE OF BLANK CASING USED:

| | | | | |
|---|---|---|---|---|
| 1 Steel | 3 RMP (SR) | 5 Wrought | 7 Fiberglass | 9 Other (specify below) |
| (2) PVC | 4 ABC | 6 Asbestos-Cement | 8 Concrete Tile | |

Blank casing diameter 4 in. Was casing pulled? Yes X No ___ If yes, how much removed 3ft.
Casing height above or below land surface -36 in.

6 GROUT PLUG MATERIAL: 1 Neat cement 2 Cement grout (3) Bentonite 4 Other

Grout Plug Intervals From 0 ft. to 23.75 ft. From ___ ft. to ___ ft. From ___ ft. to ___ ft.

What is the nearest source of possible contamination:

| | | | |
|---|---|---|---|
| 1 Septic tank | 6 Seepage pit | (11) Fuel storage | 16 Other (specify below) |
| 2 Sewer lines | 7 Pit privy | 12 Fertilizer storage | |
| 3 Watertight sewer lines | 8 Sewage lagoon | 13 Insecticide storage | |
| 4 Lateral lines | 9 Feedyard | 14 Abandoned water well | |
| 5 Cess Pool | 10 Livestock pens | 15 Oil well/ Gas well | |

Direction from well? How many feet?

| FROM | TO | CODE | PLUGGING MATERIALS |
|---|---|---|---|
| 0 | 23.75 | | Bentonite grout |
| | | | |
| | | | |
| | | | |
| | | | |
| | | | |
| | | | |

RECEIVED
JAN 08 2009
BUREAU OF WATER

7 CONTRACTOR'S OR LANDOWNER'S CERTIFICATION: This water well was plugged under my jurisdiction and was completed on (mo/day/yr) 11/4/08 and this record is true to the best of my knowledge and belief. Kansas Water Well Contractor's License No. 554 This Water Well Record was completed on (mo/day/yr) 11/17/08 under the business name of Bluestem Environmental Engineering, Inc. by (signature) Nick Hut Gary L. Watton

INSTRUCTIONS: Please fill in blanks and circle the correct answers. Send three copies to Kansas Department of Health and Environment, Bureau of Water, 1000 S W Jackson St., Ste. 420, Topeka, Kansas 66620-0001. Telephone: 785-296-3565. Send one to Water Well Owner and retain one for your records.