USE TYPEWRITER OR BALL POINT PEN-PRESS FIRMLY, PRINT CLEARLY.

T R EW sec 1/4 1/4 1/4 No.

WATER WELL RECORD
KSA 82a-1201-1215

Kansas State Dept. Of Health
(Water Well Contractors)
Forbes-Bldg. 740
Topeka, Kansas 66620

1 Location of well:	County	Township name	Fraction	Section number	Town number	Range number
	Stafford		SW NW	13	24 S	15 W

Distance and direction from nearest town or city: 2 E. ½ N.

Street address of well location if in city: Macksville, Ks

3 Owner of well: Dunne-Gardner Petroleum, Co.

Address: 200 W. Douglas, Wichita, Ks

Locate with "X" in section below:

Sketch map:

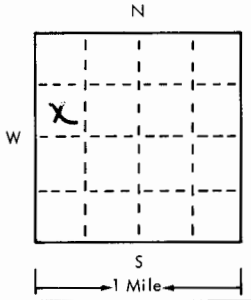

4 Well depth: 70 ft. Date of completion 7-25-75
Well diameter 6 in.

5 ☐ Cable tool ☒ Rotary ☐ Driven ☐ Dug ☐ Hollow rod ☐ Jetted ☐ Bored ☐ Reverse rotary

6 Use: ☐ Domestic ☐ Public supply ☐ Industry ☐ Irrigation ☐ Air conditioning ☐ Commercial ☐ Test well ☒ Oil Rig

7 Casing: Material PVC Height: above/below
Threaded ☐ Welded ☐ Surface 12 in.
Diam. 2 in. to 70 ft. depth Weight ____ lbs./ft.
____ in. to ____ ft. depth Drive shoe? ☐ Yes ☐ No

2 Type and color of material	From	To
Top Soil - Clay	0	45
Sand - Gravel	45	70
(use a second sheet if needed)		

8 Screen:
Manufacturer MPI
Type PVC Dia. 2
Slot/gauze 18 Length 20'
Set between 50 ft. and 70 ft.
Fittings: 48 - 3/4"
Gravel pack ☒ Yes ☐ No Size range of material ____

9 Static water level:
21 ft. below land surface Date 7-25-75

10 Pumping level below land surfaces:
____ ft. after ____ hrs. pumping ____ g.p.m.
____ ft. after ____ hrs. pumping ____ g.p.m.
Estimated maximum yield 40 g.p.m.

11 Water sample submitted:
☐ Yes ☒ No Date ____

12 Well head completion:
☐ Pitless adapter ☒ 12 Inches above grade

13 Well grouted? ☒ Yes ☐ No
☐ Neat cement ☒ Bentonite ☐ ____
Depth: From 0 ft. to 70 ft.

14 Nearest source of possible contamination:
ft. 75 Direction E Type Oil Test
Well disinfected upon completion? ☐ Yes ☐ No

15 Pump: ☒ Not installed
Manufacturer's name ____
Model number ____ HP ____ Volts ____
Length of drop pipe ____ ft. capacity ____ g.m.p.
Type:
☐ Submersible ☐ Turbine
☐ Jet ☐ Reciprocating
☐ Certrifugal ☐ Other

16 Remarks: elevation

Topography:
☐ Hill
☐ Slope
☒ Upland
☐ Valley

17 Water well contractor's certification:
This well was drilled under my jurisdiction and this report is true to the best of my knowledge and belief.
Business name Kelly's Water Well Serv License No. 186
Address R2 Great Bend Ks
Signed ____ Date 8-12-75
Authorized Representative

24 15W 13 SWNW

Forward the white, blue and pink copies to the Kansas State Dept. Of Health.

Form WWC-5

677-H