


CUMMINGS 9 15

WATER WELL RECORD Form WWC-5 KSA 82a-1212

1 LOCATION OF WATER WELL: County: STAFFORD Fraction: C 1/4 NE 1/4 Section Number: 15 Township Number: T 24 S Range Number: R 15 EW

Distance and direction from nearest town or city street address of well if located within city? MACSVILLE 1/2 E 3/4 N WESTSIDE

2 WATER WELL OWNER: STERLINE DRILLING CO RR#, St. Address, Box #: 129 City, State, ZIP Code: STERLINE KS 67379 Board of Agriculture, Division of Water Resources Application Number: 781-968

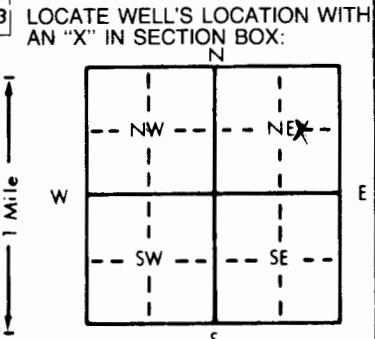

4 DEPTH OF COMPLETED WELL: 7.5 ft. ELEVATION: ... Depth(s) Groundwater Encountered: 1. 6.0 ft. 2. ... WELL'S STATIC WATER LEVEL: 20 ft. below land surface measured on mo/day/yr 1. 2. 8.2 Pump test data: Well water was ... ft. after ... hours pumping ... gpm Est. Yield ... gpm: Well water was ... ft. after ... hours pumping ... gpm Bore Hole Diameter: 7 7/8 in. to 7.5 ft., and ... in. to ... ft. WELL WATER TO BE USED AS: 5 Public water supply 8 Air conditioning 11 Injection well 1 Domestic 3 Feedlot 6 Oil field water supply 9 Dewatering 12 Other (Specify below) 2 Irrigation 4 Industrial 7 Lawn and garden only 10 Observation well Was a chemical/bacteriological sample submitted to Department? Yes ... No ... If yes, mo/day/yr sample was submitted Water Well Disinfected? Yes No

5 TYPE OF BLANK CASING USED: 1 Steel 3 RMP (SR) 5 Wrought iron 8 Concrete tile CASING JOINTS: Glued X Clamped Welded Threaded 2 PVC 4 ABS 7 Fiberglass 9 Other (specify below) Blank casing diameter: 5 in. to 9.5 ft., Dia. in. to ... ft., Dia. in. to ... ft. Casing height above land surface: 5 in., weight: 2.65 lbs./ft. Wall thickness or gauge No. 2.17

TYPE OF SCREEN OR PERFORATION MATERIAL: 1 Steel 3 Stainless steel 5 Fiberglass 8 RMP (SR) 10 Asbestos-cement 2 Brass 4 Galvanized steel 6 Concrete tile 9 ABS 11 Other (specify) 12 None used (open hole) SCREEN OR PERFORATION OPENINGS ARE: 1 Continuous slot 3 Mill slot 5 Gauzed wrapped 8 Saw cut 11 None (open hole) 2 Louvered shutter 4 Key punched 6 Wire wrapped 9 Drilled holes 10 Other (specify) 7 Torch cut 10 Other (specify)

SCREEN-PERFORATED INTERVALS: From 2.5 ft. to 7.5 ft., From ... ft. to ... ft. GRAVEL PACK INTERVALS: From 4.5 ft. to 7.5 ft., From ... ft. to ... ft.

6 GROUT MATERIAL: 1 Neat cement 2 Cement grout 3 Bentonite 4 Other Grout Intervals: From 0 ft. to 1.0 ft., From ... ft. to ... ft., From ... ft. to ... ft. What is the nearest source of possible contamination: NONE 10 Livestock pens 14 Abandoned water well 1 Septic tank 4 Lateral lines 7 Pit privy 11 Fuel storage 15 Oil well/Gas well 2 Sewer lines 5 Cess pool 8 Sewage lagoon 12 Fertilizer storage 16 Other (specify below) 3 Watertight sewer lines 6 Seepage pit 9 Feedyard 13 Insecticide storage

Direction from well? How many feet? Table with columns FROM, TO, LITHOLOGIC LOG. Data: 0 to 15 SOIL, 15 to 25 SAND, 25 to 66 CLAY, 66 to 75 GRAVEL.

7 CONTRACTOR'S OR LANDOWNER'S CERTIFICATION: This water well was (1) constructed, (2) reconstructed, or (3) plugged under my jurisdiction and was completed on (mo/day/year) 1. 2. 8.2 and this record is true to the best of my knowledge and belief. Kansas Water Well Contractor's License No. 3. 5. 7. This Water Well Record was completed on (mo/day/yr) 1. 11. 8.2 under the business name of REISER WATER WELL SERV INC by (signature) Andrew J. Reiser

INSTRUCTIONS: Use typewriter or ball point pen, PLEASE PRESS FIRMLY and PRINT clearly. Please fill in blanks, underline or circle the correct answers. Send top three copies to Kansas Department of Health and Environment, Division of Environment, Environmental Geology Section, Topeka, KS 66620. Send one to WATER WELL OWNER and retain one for your records.

OFFICE USE ONLY T 24 R 15 EW SEC. 15 CUMMINGS 9 15