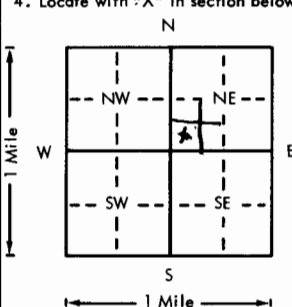


USE TYPEWRITER OR BALL POINT PEN-PRESS FIRMLY, PRINT CLEARLY.

WATER WELL RECORD
KSA 82a-1201-1215

Kansas Department of Health and Environment-Division of Environment
(Water well Contractors)
Topeka, Kansas 66620

1. Location of well: County <u>Stafford</u> Fraction <u>QSW 1/4 SW 1/4 NE 1/4</u> Section number <u>19</u> Township number <u>T 24</u> Range number <u>S 15</u> E/W	
2. Distance and direction from nearest town or city: <u>2 miles 3/4 south</u> Owner of well: <u>Stirling Drilling Co</u> Street address of well location if in city: <u>of Maxville</u> R.R. or street: _____ City, state, zip code: <u>Stirling Kansas</u>	
4. Locate with "X" in section below: Sketch map: 	6. Bore hole dia. <u>8</u> in. Completion date <u>9-26-75</u> Well depth <u>80</u> ft.
	7. <input type="checkbox"/> Cable tool <input checked="" type="checkbox"/> Rotary <input type="checkbox"/> Driven <input type="checkbox"/> Dug <input type="checkbox"/> Hollow rod <input type="checkbox"/> Jetted <input type="checkbox"/> Bored <input type="checkbox"/> Reverse rotary
5. Type and color of material	8. Use: <input type="checkbox"/> Domestic <input type="checkbox"/> Public supply <input type="checkbox"/> Industry <input type="checkbox"/> Irrigation <input type="checkbox"/> Air conditioning <input type="checkbox"/> Stock <input type="checkbox"/> Lawn <input checked="" type="checkbox"/> Oil field water <input type="checkbox"/> Other
	9. Casing: Material <u>PVC</u> Height: <u>Above</u> or below Threaded <input type="checkbox"/> Welded <input checked="" type="checkbox"/> Surface <u>1 1/2</u> in. RMP <input type="checkbox"/> PVC <input checked="" type="checkbox"/> Weight <u>22.9</u> lbs./ft. Dia. <u>5</u> in. to <u>80</u> ft. depth Wall Thickness: inches or Dia. <u> </u> in. to <u> </u> ft. depth gage No. <u>200</u>
From To	10. Screen: Manufacturer's name <u>Acersline Plastic</u> Type <u>PVC</u> Dia. <u>5</u> Slot/gauze <u>5</u> Length <u>20</u> Set between <u>60</u> ft. and <u>80</u> ft. <u> </u> ft. and <u> </u> ft. Gravel pack? <u>yes</u> Size range of material <u>1/8 - 1/4</u>
	11. Static water level: <u>14</u> ft. below land surface Date <u>9-26-75</u> mo./day/yr.
	12. Pumping level below land surfaces: <u> </u> ft. after <u> </u> hrs. pumping <u> </u> g.p.m. <u> </u> ft. after <u> </u> hrs. pumping <u> </u> g.p.m. Estimated maximum yield <u> </u> g.p.m.
	13. Water sample submitted: <u> </u> mo./day/yr. <input type="checkbox"/> Yes <input checked="" type="checkbox"/> No Date <u> </u>
	14. Well head completion: <input type="checkbox"/> Pitless adapter <u>12</u> Inches above grade
	15. Well grouted? <u>yes</u> With: <input type="checkbox"/> Neat cement <input checked="" type="checkbox"/> Bentonite <input type="checkbox"/> Concrete Depth: From <u>0</u> ft. to <u>10</u> ft.
	16. Nearest source of possible contamination: <u>None</u> ft. <u> </u> Direction <u> </u> Type <u> </u> Well disinfected upon completion? <input type="checkbox"/> Yes <input type="checkbox"/> No
	17. Pump: <input checked="" type="checkbox"/> Not installed Manufacturer's name <u> </u> Model number <u> </u> HP <u> </u> Volts <u> </u> Length of drop pipe <u> </u> ft. capacity <u> </u> g.p.m. Type: <input type="checkbox"/> Submersible <input type="checkbox"/> Turbine <input type="checkbox"/> Jet <input type="checkbox"/> Reciprocating <input type="checkbox"/> Centrifugal <input type="checkbox"/> Other
18. Elevation:	19. Remarks:
Topography: <input type="checkbox"/> Hill <input checked="" type="checkbox"/> Slope <input type="checkbox"/> Upland <input type="checkbox"/> Valley	20. Water well contractor's certification: This well was drilled under my jurisdiction and this report is true to the best of my knowledge and belief. <u>Myers Water Well 143</u> Business name <u>Great Bend KS</u> License No. <u> </u> Address <u> </u> Signed <u>Myers</u> Date <u>9-26-75</u> Authorized representative

T 24 R 15 E 19 CSW 1/4 SW 1/4 NE

Forward the white, blue and pink copies to the Department of Health and Environment

Form WWC-5