

USE TYPEWRITER OR BALL POINT PEN-PRESS FIRMLY, PRINT CLEARLY.


T R EW sec 1/4 1/4 1/4 No.

WATER WELL RECORD
KSA 82a-1201-1215

Kansas State Dept. Of Health
(Water Well Contractors)
Forbes-Bldg. 740
Topeka, Kansas 66620

1 Location of well:	County Stafford	Township name Farmington	Fraction CNW₄	Section number 23	Town number T24S	Range number R15W
---------------------	---------------------------	------------------------------------	------------------------------------	-----------------------------	----------------------------	-----------------------------

Distance and direction from nearest town or city: 1 mi. East of Macksville, Kansas Street address of well location if in city:	3 Owner of well: Don Sutor Address: St. John, Kansas
---	---

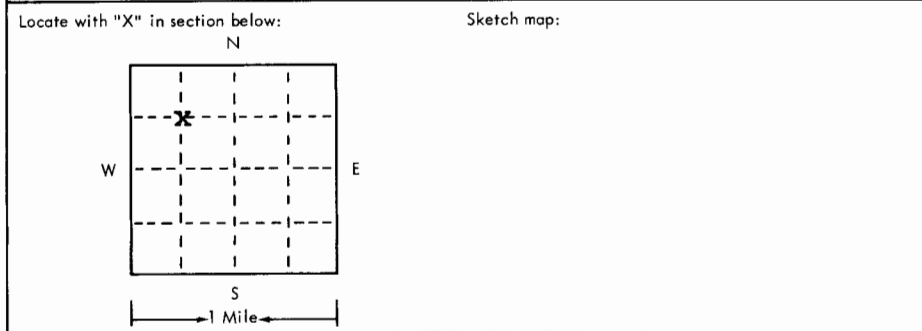

2	Type and color of material	From	To
	Sandy top soil	0	3
	Sandy clay & gray clay	3	15
	Sandy clay & fine sand	15	40
	Fine sand & sandy clay streak	40	55
	Fine sand	55	65
	Sand & gravel	65	95
	Hard limestone streaks & gravel	95	100
	(use a second sheet if needed)		

4 Well depth: **100** ft. Date of completion **4-22-75**
Well diameter **24** in.

5 Cable tool Rotary Driven Dug
 Hollow rod Jetted Bored Reverse rotary

6 Use: Domestic Public supply Industry
 Irrigation Air conditioning Commercial
 Test well

7 Casing: Material **Steel** Height: **Above**/below
Threaded Welded Surface **12** in.
Diam. Weight **30.3** lbs./ft.
16 in. to **60** ft. depth Drive shoe? Yes No
in. to in. depth!

8 Screen:
Manufacturer **Doerr**
Type **Double-slot** Dia. **16"**
Slot gauze **1/8** Length **40'**
Set between **60** ft. and **100** ft.
Fittings: Gravel pack Yes No Size range of material **3/8-200**

9 Static water level:
16 ft. below land surface Date **4-22-75**

10 Pumping level below land surfaces: **N/C**
ft. after hrs. pumping g.p.m.
ft. after hrs. pumping g.p.m.
Estimated maximum yield g.p.m.

11 Water sample submitted:
 Yes No Date

12 Well head completion:
 Pitless adapter **12** Inches above grade

13 Well grouted? Yes No
 Neat cement Bentonite
Depth: From **0** ft. to **10** ft.

14 Nearest source of possible contamination:
ft. Direction Type
Well disinfected upon completion? Yes No

15 Pump: Not installed
Manufacturer's name
Model number HP Volts
Length of drop pipe ft. capacity g.m.p.
Type:
 Submersible Turbine
 Jet Reciprocating
 Centrifugal Other

16 Remarks: elevation

Topography:
 Hill
 Slope
 Upland
 Valley

17 Water well contractor's certification:
This well was drilled under my jurisdiction and this report is true to the best of my knowledge and belief.
Clarke Well & Eq., Inc. **185**
Business name License No.
Address **Great Bend, Ks**
Signed **W. Clarke** Date **4-22-75**
Authorized representative