USE TYPEWRITER OR BALL POINT PEN-PRESS FIRMLY, PRINT CLEARLY.

WATER WELL RECORD
KSA 82a-1201-1215

Kansas Department of Health and Environment-Division of Environment
(Water well Contractors)
Topeka, Kansas 66620

1. Location of well:	County	Fraction	Section number	Township number	Range number
	Stafford	NW 1/4 SW 1/4 SW 1/4	28	T 24 S	R 15 E/W

2. Distance and direction from nearest town or city:
1½ miles Southwest of Macksville, KS
Street address of well location if in city:

3. Owner of well: Alvin Brensing
R.R. or street: (?)
City, state, zip code: Hudson, KS 67545

4. Locate with "X" in section below: Sketch map:

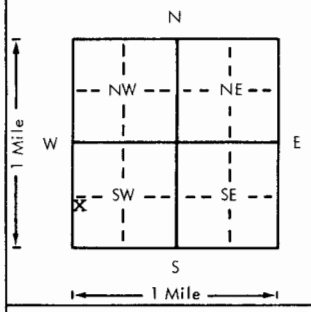

6. Bore hole dia. 24 in. Completion date 11-28-77
Well depth 96 ft. (Well Drilled)

7. __ Cable tool __ Rotary __ Driven __ Dug
__ Hollow rod __ Jetted __ Bored X Reverse rotary

8. Use: __ Domestic __ Public supply __ Industry
X Irrigation __ Air conditioning __ Stock
__ Lawn __ Oil field water __ Other

9. Casing: Material Steel Height: (Above) or below
Threaded ___ Welded X Surface 12 in.
RMP ___ PVC ___ Weight 30.3 lbs./ft.
Dia. 16 in. to 56 ft. depth Wall Thickness: inches or
Dia. ___ in. to ___ ft. depth gage No. 7 ga.

5. Type and color of material	From	To
Top soil	0	3
▮▮▮ Brown & gray clay & limestone streaks	3	27
Sand & sandy clay	27	38
White clay & limestone	38	54
Sand & gravel	54	95
Soft brown clay	95	96
(Use a second sheet if needed)		

10. Screen: Manufacturer's name Doerr
Type Double-slot Dia. 16"
Slot/gauze 1/8" Length 40'
Set between 56 ft. and 96 ft.
___ ft. and ___ ft.
Gravel pack? yes Size range of material 3/8-200

11. Static water level: mo./day/yr.
12'6" ft. below land surface Date 11-28-77

12. Pumping level below land surfaces: N/C
___ ft. after ___ hrs. pumping ___ g.p.m.
___ ft. after ___ hrs. pumping ___ g.p.m.
Estimated maximum yield ___ g.p.m.

13. Water sample submitted: mo./day/yr.
___ Yes X No Date ___

14. Well head completion:
___ Pitless adapter 12 Inches above grade

15. Well grouted? yes
With: X Neat cement ___ Bentonite ___ Concrete
Depth: From 0 ft. to 10 ft.

16. Nearest source of possible contamination: FIELD
ft. ___ Direction ___ Type ___
Well disinfected upon completion? ___ Yes X No

17. Pump: ___ Not installed
Manufacturer's name Peerless Pump Co.
Model number 14LC-1 HP 80 Volts ---
Length of drop pipe 70 ft. capacity 1600 g.p.m.
Type:
___ Submersible X Turbine
___ Jet ___ Reciprocating
___ Centrifugal ___ Other

18. Elevation:
Topography:
___ Hill
___ Slope
___ Upland
___ Valley

19. Remarks:

20. Water well contractor's certification:
This well was drilled under my jurisdiction and this report is true to the best of my knowledge and belief. 185
Clarke Well & Equipment, Inc.
Business name License No.
Address Great ▮▮▮▮Bend, KS 67530
Signed [signature] Date 4-4-78
Authorized representative

Forward the white, blue and pink copies to the Department of Health and Environment

Form WWC-5

MI-1023

T 24 R 15 E Sec 28 1/4 1/4 1/4 NW SW SW