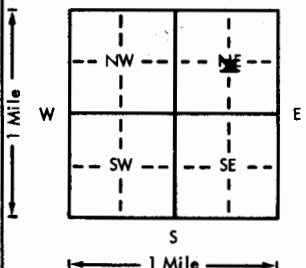


USE TYPEWRITER OR BALL
POINT PEN-PRESS FIRMLY,
PRINT CLEARLY.

WATER WELL RECORD
KSA 82a-1201-1215

Kansas Department of Health and
Environment-Division of Environment
(Water well Contractors)
Topeka, Kansas 66620

1. Location of well:	County Stafford	Fraction 1/4 1/4 CNE 1/4	Section number 29	Township number T 24 S	Range number R 15 E
2. Distance and direction from nearest town or city: 1 1/2 mi. Southwest of Macksville, KS Street address of well location if in city:			3. Owner of well: Alvin Brensing R.R. or street: (?) City, state, zip code: Hudson, KS 67545		
4. Locate with "X" in section below: N W E S 1 Mile			Sketch map: 		
5. Type and color of material			From	To	6. Bore hole dia. 24 in. Completion date 3-23-76 Well depth 100 ft.
Top soil			0	3	7. ☐ Cable tool ☐ Rotary ☐ Driven ☐ Dug ☐ Hollow rod ☐ Jetted ☐ Bored ☒ Reverse rotary
Brown & gray clay & sand streaks			3	27	8. Use: ☐ Domestic ☐ Public supply ☐ Industry ☒ Irrigation ☐ Air conditioning ☐ Stock ☐ Lawn ☐ Oil field water ☐ Other
White clay, Lime & sand streaks			27	61	9. Casing: Material Steel Height Above or below Threaded ☐ Welded ☒ Surface 12 in. RMP ☐ PVC ☐ Weight 30.3 lbs./ft. Dia. 16 in. to 60 ft. depth Wall Thickness: inches or Dia. ☐ in. to ☐ ft. depth gauge No. 7 ga.
White clay & gravel streaks			61	66	10. Screen: Manufacturer's name Doerr Type Double-slot Dia. 16" Slot gauge 1/8 Length 40' Set between 60 ft. and 100 ft. ft. and ☐ ft. Gravel pack? Yes Size range of material 3/8-200
Sand & gravel			66	99	11. Static water level: ☐ mo./day/yr. 11 1/2 ft. below land surface Date 1-22-76
Dakota clay			99	100	12. Pumping level below land surfaces: N/C ☐ ft. after ☐ hrs. pumping ☐ g.p.m. ☐ ft. after ☐ hrs. pumping ☐ g.p.m. Estimated maximum yield ☐ g.p.m.
					13. Water sample submitted: ☐ mo./day/yr. Yes ☒ No ☐ Date ☐
					14. Well head completion: ☐ Pitless adapter 12 Inches above grade
					15. Well grouted? Yes With: ☒ Neat cement ☐ Bentonite ☐ Concrete Depth: From 0 ft. to 10 ft.
					16. Nearest source of possible contamination: ft. ☐ Direction ☐ Type ☐ Well disinfected upon completion? ☐ Yes ☒ No
					17. Pump: ☐ Not installed Manufacturer's name Berkeley Pump Co. Model number 1202M-4 HP 80 Volts ☐ Length of drop pipe 70 ft. capacity 900 g.p.m. Type: ☐ Submersible ☒ Turbine ☐ Jet ☐ Reciprocating ☐ Centrifugal ☐ Other
(Use a second sheet if needed)					20. Water well contractor's certification: This well was drilled under my jurisdiction and this report is true to the best of my knowledge and belief. Clarke Well & Eq., Inc. 185 Business name License No. Address Great Bend, KS Signed [Signature] Date 3-30-76 Authorized representative
18. Elevation:	19. Remarks:				
Topography: ☐ Hill ☐ Slope ☐ Upland ☐ Valley					

Forward the white, blue and pink copies to the Department of Health and Environment

Form WWC-5