


1 LOCATION OF WATER WELL: County: Stafford	Fraction C 1/4 NE 1/4 NW 1/4	Section Number 19	Township Number T 24 S	Range Number R 15W 15W
--	---------------------------------	----------------------	---------------------------	--------------------------------------

Distance and direction from nearest town or city street address of well if located within city?
3 miles West and 1 1/2 mile South of Macksville, Kansas

2	WATER WELL OWNER:	L. Hobart	Sterling Drilling Company - Young #2-19
	RR#, St. Address, Box # :	1709 College	P. O. Box 129 Board of Agriculture, Division of Water Resources
	City, State, ZIP Code :	Larned, Kansas 67550	Sterling, Kansas 67579-0129 Application Number: 930149

3	LOCATE WELL'S LOCATION WITH AN "X" IN SECTION BOX:	4	DEPTH OF COMPLETED WELL.....	80	ft.	ELEVATION:.....	Unknown
			Depth(s) Groundwater Encountered.....	1	33	ft.	2
							3
							ft.

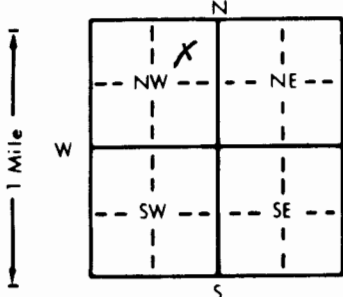

4) DEPTH OF COMPLETED WELL 80 ft. ELEVATION: Unknown
 Depth(s) Groundwater Encountered 1. 33 ft. 2. ft. 3. ft.
 WELL'S STATIC WATER LEVEL 33 ft. below land surface measured on mo/day/yr 5-27-93
 Pump test data: Well water was ft. after hours pumping gpm
 Est. Yield 60 gpm: Well water was ft. after hours pumping gpm
 Bore Hole Diameter 8 in. to 80 ft., and in. to ft.
 WELL WATER TO BE USED AS: 5 Public water supply 8 Air conditioning 11 Injection well
 1 Domestic 3 Feedlot 6 Oil field water supply 9 Dewatering 12 Other (Specify below)
 2 Irrigation 4 Industrial 7 Lawn and garden only 10 Monitoring well
 Was a chemical/bacteriological sample submitted to Department? Yes No X; If yes, mo/day/yr sample was sub-
 mitted Water Well Disinfected? Yes No X

5	TYPE OF BLANK CASING USED:		5 Wrought iron	8 Concrete tile	CASING JOINTS: Glued ☒ . . . Clamped Welded Threaded
	1 Steel	3 RMP (SR)	6 Asbestos-Cement	9 Other (specify below)	
	2 PVC	4 ABS	7 Fiberglass		

Blank casing diameter 5 . . . in. to . . . 60 . . . ft. Dia in. to ft. Dia in. to ft.
Casing height above land surface 12 . . . in. weight 2.8 . . . lbs./ft. Wall thickness or gauge No. SCH 40

TYPE OF SCREEN OR PERFORATION MATERIAL:

1 Steel	3 Stainless steel	5 Fiberglass	7 PVC	10 Asbestos-cement
2 Brass	4 Galvanized steel	6 Concrete tile	8 RMP (SR)	11 Other (specify)
			9 ABS	12 None used (open hole)

SCREEN OR PERFORATION OPENINGS ARE:

1 Continuous slot	3 Mill slot	5 Gauzed wrapped	8 Saw cut	11 None (open hole)
2 Louvered shutter	4 Key punched	6 Wire wrapped	9 Drilled holes	
		7 Torch cut	10 Other (specify)	

SCREEN-PERFORATED INTERVALS:	From 60	ft. to 80	ft., From	ft. to	ft.
	From	ft. to	ft., From	ft. to	ft.
GRAVEL PACK INTERVALS:	From 20	ft. to 80	ft., From	ft. to	ft.
	From	ft. to	ft., From	ft. to	ft.

6 GROUT MATERIAL: 1 Neat cement 2 Cement grout 3 Bentonite 4 Other

Grout Intervals: From 0 ft. to 20 ft. From ft. to ft. From ft. to ft.

What is the nearest source of possible contamination:

1 Septic tank	4 Lateral lines	7 Pit privy	10 Livestock pens	14 Abandoned water well
2 Sewer lines	5 Cess pool	8 Sewage lagoon	11 Fuel storage	15 Oil well/Gas well
3 Watertight sewer lines	6 Seepage pit	9 Feedyard	12 Fertilizer storage	16 Other (specify below)
			13 Insecticide storage	

Direction from well? South How many feet? 60

[illegible]

7 CONTRACTOR'S OR LANDOWNER'S CERTIFICATION: This water well was (1) constructed, (2) reconstructed, or (3) plugged under my jurisdiction and was completed on (mo/day/year) May 21, 1994 and this record is true to the best of my knowledge and belief. Kansas Water Well Contractor's License No. 151 This Water Well Record was completed on (mo/day/yr) June 7, 1994 under the business name of Sterling Drilling Company by (signature) R. J. J. [illegible]

INSTRUCTIONS: Use typewriter or ball point pen. PLEASE PRESS FIRMLY and PRINT clearly. Please fill in blanks, underline or circle the correct answers. Send top three copies to Kansas Department of Health and Environment, Bureau of Water, Topeka, Kansas 66620-0001. Telephone: 913-296-5545. Send one to WATER WELL OWNER and retain one for your records.

OFFICE USE ONLY	T	R	EW	SEC
-----------------	---	---	----	-----