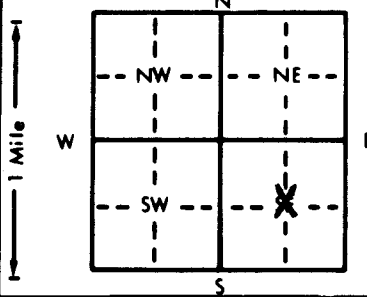


1 LOCATION OF WATER WELL: Fraction $\frac{1}{4}$ NW $\frac{1}{4}$ SE $\frac{1}{4}$ Section Number 7 Township Number T 24 S Range Number R 16 **W**
 County: Edwards
 Distance and direction from nearest town or city street address of well if located within city?
1 1/2 north 1/2 west of Belpre, Ks.

2 WATER WELL OWNER: Clinton Russell
 RR#, St. Address, Box # : Belpre, Ks. 67519 Board of Agriculture, Division of Water Resources
 City, State, ZIP Code : Application Number: 37474

3 LOCATE WELL'S LOCATION WITH AN "X" IN SECTION BOX:

 4 DEPTH OF COMPLETED WELL: 83 ft. ELEVATION:
 Depth(s) Groundwater Encountered 1. 30 ft. 2. 83 ft. 3. 85 ft.
 WELL'S STATIC WATER LEVEL 30 ft. below land surface measured on mo/day/yr 1-8-85
 Pump test data: Well water was 38 1/2 ft. after 1 1/2 hours pumping 700 gpm
 Est. Yield 41 1/2 gpm: Well water was 41 1/2 ft. after 2 hours pumping 1000 gpm
 Bore Hole Diameter 30 in. to 83 ft., and 30 in. to 83 ft.
 WELL WATER TO BE USED AS:
 5 Public water supply 8 Air conditioning 11 Injection well
 1 Domestic 3 Feedlot 6 Oil field water supply 9 Dewatering 12 Other (Specify below)
~~2 Irrigation~~ 4 Industrial 7 Lawn and garden only 10 Observation well
 Was a chemical/bacteriological sample submitted to Department? Yes No X; If yes, mo/day/yr sample was submitted
 Water Well Disinfected? Yes hth No

5 TYPE OF BLANK CASING USED:
 1 Steel 3 RMP (SR) 5 Wrought iron 8 Concrete tile CASING JOINTS: Glued Clamped
 2 PVC 4 ABS 6 Asbestos-Cement 9 Other (specify below) Welded
 7 Fiberglass Threaded
 Blank casing diameter 16 in. to 59 ft., Dia 16 in. to 59 ft., Dia 16 in. to 59 ft.
 Casing height above land surface 12 in., weight 12 lbs./ft. Wall thickness or gauge No. SDR 32.5
 TYPE OF SCREEN OR PERFORATION MATERIAL:
 1 Steel 3 Stainless steel 5 Fiberglass 7 PVC 10 Asbestos-cement
 2 Brass 4 Galvanized steel 6 Concrete tile 8 RMP (SR) 11 Other (specify)
 9 ABS 12 None used (open hole)
 SCREEN OR PERFORATION OPENINGS ARE:
 1 Continuous slot 3 Mill slot 5 Gauzed wrapped 8 Saw cut 11 None (open hole)
 2 Louvered shutter 4 Key punched 6 Wire wrapped 9 Drilled holes
 7 Torch cut 10 Other (specify)
 SCREEN-PERFORATED INTERVALS: From 50 ft. to 83 ft., From 50 ft. to 83 ft., From 50 ft. to 83 ft.
 GRAVEL PACK INTERVALS: From 20 ft. to 83 ft., From 20 ft. to 83 ft., From 20 ft. to 83 ft.

6 GROUT MATERIAL: 1 Neat cement 2 Cement grout 3 Bentonite 4 Other
 Grout intervals: From 0 ft. to 20 ft., From 0 ft. to 20 ft., From 0 ft. to 20 ft.
 What is the nearest source of possible contamination:
 1 Septic tank 4 Lateral lines 7 Pit privy 10 Livestock pens 14 Abandoned water well
 2 Sewer lines 5 Cess pool 8 Sewage lagoon 11 Fuel storage 15 Oil well/Gas well
 3 Watertight sewer lines 6 Seepage pit 9 Feedyard 12 Fertilizer storage 16 Other (specify below)
 13 Insecticide storage none
 Direction from well? How many feet?

FROM	TO	LITHOLOGIC LOG	FROM	TO	LITHOLOGIC LOG
0	5	Sandy top soil			
5	18	Tan gritty clay			
18	28	Fine sand with tan clay and white broken rock			
28	46	Sand and gravel			
46	48	Tan Clay			
48	62	Sand and gravel			
62	64	Tan clay			
64	83	Sand and gravel			
83	112	Light gray clay			



7 CONTRACTOR'S OR LANDOWNER'S CERTIFICATION: This water well was (1) constructed, (2) reconstructed, or (3) plugged under my jurisdiction and was completed on (mo/day/year) 12-23-87 and this record is true to the best of my knowledge and belief. Kansas Water Well Contractor's License No. 134 This Water Well Record was completed on (mo/day/yr) 1-4-87 under the business name of Rosencrantz-Bemis by (signature) Judith Reson

INSTRUCTIONS: Use typewriter or ball point pen. PLEASE PRESS FIRMLY and PRINT clearly. Please fill in blanks, underline or circle the correct answers. Send top three copies to Kansas Department of Health and Environment, Office of Oil Field and Environmental Geology, Regulation and Permitting Section, Topeka, Kansas 66620-7500, Telephone: 913-862-9360. Send one to WATER WELL OWNER and retain one for your records.

OFFICE USE ONLY T R EW SEC. 1/4 1/4 1/4