


1 LOCATION OF WATER WELL: County: <u>Edwards</u>	Fraction <u>NE 1/4 NE 1/4 NW 1/4</u>	Section Number <u>8</u>	Township Number <u>T 24 S</u>	Range Number <u>R 16W E/W</u>
--	---	----------------------------	----------------------------------	----------------------------------

Distance and direction from nearest town or city street address of well if located within city?
2 N, 1/2 W of Belpre, Kansas

2 WATER WELL OWNER: <u>Harold Smith</u>	<u>Sterling Drilling Co.</u>	<u>Smith #2</u>
RR#, St. Address, Box # : <u>Route 1</u>	<u>Box 129</u>	Board of Agriculture, Division of Water Resources
City, State, ZIP Code : <u>Macksville, Ks. 67557</u>	<u>Sterling, Kansas 67579</u>	Application Number: <u>920320</u>

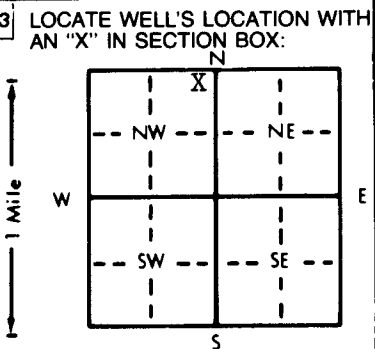

4 DEPTH OF COMPLETED WELL: 76 ft. ELEVATION: Unknown

Depth(s) Groundwater Encountered 1.35 ft. 2 ft. 3 ft.

WELL'S STATIC WATER LEVEL 35 ft. below land surface measured on mo/day/yr 9/28/92

Pump test data: Well water was _____ ft. after _____ hours pumping _____ gpm

Est. Yield 60 gpm: Well water was _____ ft. after _____ hours pumping _____ gpm

Bore Hole Diameter: 8 in. to 7.6 ft., and _____ in. to _____ ft.

WELL WATER TO BE USED AS:

5 Public water supply	8 Air conditioning	11 Injection well
1 Domestic	3 Feedlot	6 <u>Oil field water supply</u>
2 Irrigation	4 Industrial	7 Lawn and garden only
		10 Monitoring well

12 Other (Specify below)

Was a chemical/bacteriological sample submitted to Department? Yes No; If yes, mo/day/yr sample was submitted _____

Water Well Disinfected? Yes No

5 TYPE OF BLANK CASING USED:

1 Steel	3 RMP (SR)	6 Asbestos-Cement	9 Other (specify below)	Welded
2 <u>PVC</u>	4 ABS	7 Fiberglass		Threaded

Blank casing diameter 5 in. to 56 ft., Dia _____ in. to _____ ft., Dia _____ in. to _____ ft.

Casing height above land surface 12 in., weight 2.8 lbs./ft. Wall thickness or gauge No. Sch. 40

TYPE OF SCREEN OR PERFORATION MATERIAL:

1 Steel	3 Stainless steel	5 Fiberglass	8 RMP (SR)	11 Other (specify)
2 Brass	4 Galvanized steel	6 Concrete tile	9 ABS	12 None used (open hole)

SCREEN OR PERFORATION OPENINGS ARE:

1 Continuous slot	3 Mill slot	5 Gauzed wrapped	8 <u>Saw cut</u>	11 None (open hole)
2 Louvered shutter	4 Key punched	6 Wire wrapped	9 Drilled holes	
		7 Torch cut	10 Other (specify)	

SCREEN-PERFORATED INTERVALS: From 56 ft. to 76 ft., From _____ ft. to _____ ft.

GRAVEL PACK INTERVALS: From 20 ft. to 76 ft., From _____ ft. to _____ ft.

6 GROUT MATERIAL: 1 Neat cement 2 Cement grout 3 Bentonite 4 Other

Grout Intervals: From 0 ft. to 20 ft., From _____ ft. to _____ ft., From _____ ft. to _____ ft.

What is the nearest source of possible contamination:

1 Septic tank	4 Lateral lines	7 Pit privy	10 Livestock pens	14 Abandoned water well
2 Sewer lines	5 Cess pool	8 Sewage lagoon	11 Fuel storage	15 <u>Oil well/Gas well</u>
3 Watertight sewer lines	6 Seepage pit	9 Feedyard	12 Fertilizer storage	16 Other (specify below)
			13 Insecticide storage	

Direction from well? South How many feet? 60

FROM	TO	LITHOLOGIC LOG	FROM	TO	PLUGGING INTERVALS
0	38	Sandy clay			
38	76	Sand and gravel			

7 CONTRACTOR'S OR LANDOWNER'S CERTIFICATION: This water well was (1) constructed, (2) reconstructed, or (3) plugged under my jurisdiction and was completed on (mo/day/year) 9/28/92 and this record is true to the best of my knowledge and belief. Kansas Water Well Contractor's License No. 186 This Water Well Record was completed on (mo/day/yr) 9/30/92 under the business name of Kelly's Water Well Service, Inc. by (signature) [Signature]

INSTRUCTIONS: Use typewriter or ball point pen. PLEASE PRESS FIRMLY and PRINT clearly. Please fill in blanks, underline or circle the correct answers. Send top three copies to Kansas Department of Health and Environment, Bureau of Water, Topeka, Kansas 66620-0001. Telephone: 913-296-5545. Send one to WATER WELL OWNER and retain one for your records.

OFFICE USE ONLY T R E/W SEC 1/4 1/4 1/4